


STATE OF KANSAS  
STATE CORPORATION COMMISSION

WELL PLUGGING RECORD

Give All Information Completely  
Make Required Affidavit  
Mail or Deliver Report to:  
Conservation Division  
State Corporation Commission  
800 Bitting Building  
Wichita, Kansas

Barton County, Sec. 5 Twp. 20 Rge. 15 <sup>11</sup>/<sub>10</sub> (W)

Location as "NE/CNW/SW" or footage from lines NW/4 SW/4 SE/4  
Lease Owner Martin Wunderlich  
Lease Name B. Smith Well No. 1  
Office Address 206 Patterson Building, Omaha, Nebraska.  
Character of Well (completed as Oil, Gas or Dry Hole) Dry Hole  
Date well completed March 30, 19 52  
Application for plugging filed March 30, 19 52  
Application for plugging approved March 30, 19 52  
Plugging commenced March 30, 19 52  
Plugging completed March 30, 19 52  
Reason for abandonment of well or producing formation Dry Hole

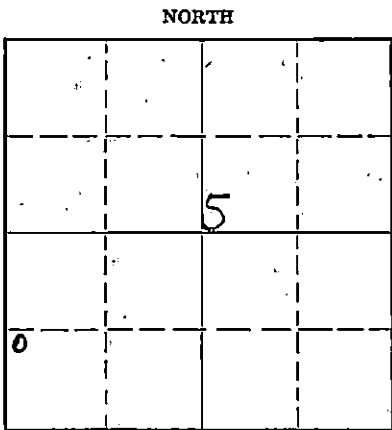

Locate well correctly on above  
Section Plat

If a producing well is abandoned, date of last production 19  
Was permission obtained from the Conservation Division or its agents before plugging was commenced? Yes.

Name of Conservation Agent who supervised plugging of this well C. D. Stough, Great Bend, Kansas.  
Producing formation Depth to top Bottom Total Depth of Well 3765 Feet  
Show depth and thickness of all water, oil and gas formations.

OIL, GAS OR WATER RECORDS

CASING RECORD

Formation	Content	From	To	Size	Put In	Pulled Out
				8 5/8"	1025	None

Describe in detail the manner in which the well was plugged, indicating where the mud fluid was placed and the method or methods used in introducing it into the hole. If cement or other plugs were used, state the character of same and depth placed, from feet to feet for each plug set.

Heavy rotary mud 3765 to 270 20 sacks cement. Cement plug at 270'  
Cement plug at 30' Cemented with 10 sacks cement.

RECEIVED  
STATE OF KANSAS  
MAR 31 1952  
CONSERVATION DIVISION  
Wichita, Kansas  
3-31-1952

(If additional description is necessary, use BACK of this sheet)

Name of Plugging Contractor H. M. Williams Drilling Company  
Address 701 Bitting Building, Wichita 2, Kansas.

STATE OF Kansas, COUNTY OF Sedgewick, ss.  
M. W. McClure, (employee of owner) or (owner or operator) of the above-described well,  
being first duly sworn on oath, says: That I have knowledge of the facts, statements, and matters herein contained and the log of the above-described well as filed and that the same are true and correct. So help me God.

(Signature) *M. W. McClure*  
701 Bitting Building, Wichita, Kansas  
(Address)

SUBSCRIBED AND SWORN to before me this 31st day of March 19 52.

My commission expires Feb. 2, 1953.

*R. P. Company*  
Notary Public.

PLUGGING  
FILE SEC 5 Twp 20 R 15 S  
BOOK PAGE 5 LINE 39

Total Depth 3765  
 Drilling Comm. 3-14-52  
 Drilling Comp. 3-30-52

Martin Wunderlich  
 B. Smith Well No. 1.

Sec. 5 T. 20 S R. 15W  
 NW SW SW  
 Barton County, Kansas.  
 Production. Dry.  
 Elevation

8 5/8" Casing 1025'  
 625 Sacks Cement.

Figures indicate bottom of formations.

Soil and shale shells	320
Shale shells	414
Sand	534
Shale shells	590
Red Bed	710
Shale shells	825
Shale red bed	900
Shale	1030
Shale and red bed	1115
Shale & shells	1475
Salt	1760
Shale	1880
Lime & Shale	2150
Lime	2340
Shale & lime	2365
Shale	2745
Lime	2835
Lime & shale	2890
Lime	2970
Lime & shale	3035
Lime	3080
Lime & shale	3105
Lime	3200
Shale & lime	3255
Lime	3340
Lime & shale	3580 (Top K.C. Lime 3400)
Shale & chalky lime	3605
Shale & lime	3690
Conglomerate	3746 (Top Arbuckle Lime 3746)
Arbuckle Lime	3765
Total Depth, Ground Level	3765

STATE OF KANSAS )  
 COUNTY OF SEDGWICK ) SS.

This is to certify that this is a true and correct copy of the drillers log of the above well.

*M. A. Gline*  
 \_\_\_\_\_

Subscribed and sworn to before me, a Notary Public, this 31st day of March, 1952.

My commission expires:  
 Feb. 2, 1953.

*R. P. Conroy*  
 \_\_\_\_\_  
 Notary Public.

REC  
 STATE OF KANSAS  
 MAR 31 1952  
 CONSERVATION DIVISION  
 WICHITA, KANSAS

**PLUGGING**  
 FILE SEC 5 T 20 S R 15 W  
 BOOK PAGE 5 LINE 37