

STATE CORPORATION COMMISSION OF KANSAS
OIL & GAS CONSERVATION DIVISION

WELL COMPLETION OR RECOMPLETION FORM
ACO-1 WELL HISTORY

DESCRIPTION OF WELL AND LEASE

Operator: License # 5140
Name Frontier Oil Company
Address 125 N. Market, Ste 1720
Wichita
City/State/Zip Kansas 67202

Purchaser N/A

Operator Contact Person Jean Angle
Phone 316-263-1201

Contractor: License # 5302
Name Red Tiger Drilling Company

Wellsite Geologist Richard Parker
Phone 913-483-5348

Designate Type of Completion
 New Well Re-Entry Workover
 Oil SWD Temp Abd
 Gas Inj Delayed Comp.
 Dry Other (Core, Water Supply etc.)

If OWWO: old well info as follows:
Operator
Well Name
Comp. Date Old Total Depth


WELL HISTORY

Drilling Method:
 Mud Rotary Air Rotary Cable
6-24-85 7-2-85 7-2-85
Spud Date Date Reached TD Completion Date
4120' N/A
Total Depth PBTD

Amount of Surface Pipe Set and Cemented at 207 feet
Multiple Stage Cementing Collar Used? Yes No
If yes, show depth set.....feet
If alternate 2 completion, cement circulated from.....feet depth to.....w/.....SX cmt

API NO. 15-145-21,214:0000
County Pawnee
50'E NW NW SW Sec 21 Twp 20S Rge 18W East West
2310 Ft North from Southeast Corner of Section
4900 Ft West from Southeast Corner of Section
(Note: Locate well in section plat below)
Lease Name Cox "A" Well # 2
Field Name (Wildcat)
Producing Formation N/A
Elevation: Ground 2213' KB 2218'

Section Plat

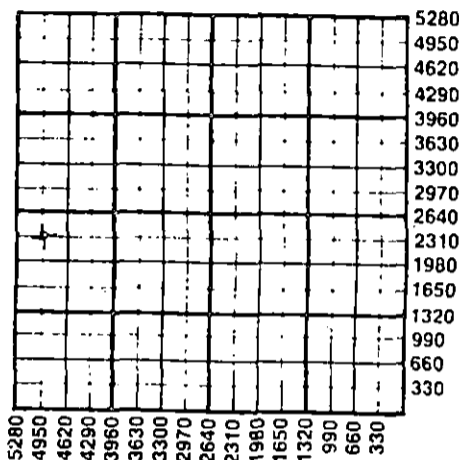

WATER SUPPLY INFORMATION

Disposition of Produced Water: Disposal Repressuring
Docket # N/A


Questions on this portion of the ACO-1 call:

Water Resources Board (913) 296-3717
Source of Water: Dallas Hiebert, Rozel, Ks.
Division of Water Resources Permit #
 Groundwater.....Ft North from Southeast Corner (Well)Ft West from Southeast Corner of Sec Twp Rge East West
 Surface Water 2100 Ft North from Southeast Corner (Stream, pond, etc) 2400 Ft West from Southeast Corner Sec 14 Twp 20S Rge 18 East West
 Other (explain).....
(purchased from city, R.W.O. #)

INSTRUCTIONS: This form shall be completed in duplicate and filed with the Kansas Corporation Commission, 200 Colorado Derby Building, Wichita, Kansas 67202, within 90 days after completion or recompletion of any well. Rule 82-3-130 and 82-3-107 apply.
Information on side two of this form will be held confidential for a period of 12 months if requested in writing and submitted with the form. See rule 82-3-107 for confidentiality in excess of 12 months.
One copy of all wireline logs and drillers time log shall be attached with this form. Submit CP-4 form with all plugged wells. Submit CP-111 form with all temporarily abandoned wells.

All requirements of the statutes, rules and regulations promulgated to regulate the oil and gas industry have been fully complied with and the statements herein are complete and correct to the best of my knowledge.

Signature *Jean Angle*
Title Agent Date 7-19-85

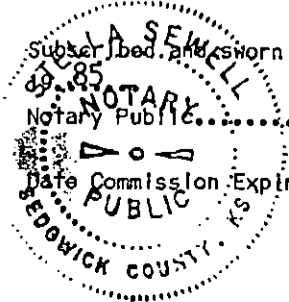

Subscribed and sworn to before me this 19th day of July 1985
Stella Sewell
Notary Public

K.C.C. OFFICE USE ONLY
 Letter of Confidentiality Attached
 Wireline Log Received
 Drillers Timelog Received
Distribution
 KCC SWD/Rep NGPA
 KGS Plug Other (Specify)
RECEIVED
STATE CORPORATION COMMISSION

Operator Name Frontier Oil Company Lease Name Cox "A" Well # 2

Sec. 21 Twp. 20S Rge. 18W East West County Pawnee

WELL LOG

INSTRUCTIONS: Show Important tops and base of formations penetrated. Detail all cores. Report all drill stem tests giving interval tested, time tool open and closed, flowing and shut-in pressures, whether shut-in pressure reached static level, hydrostatic pressures, bottom hole temperature, fluid recovery, and flow rates if gas to surface during test. Attach extra sheet if more space is needed. Attach copy of log. Not logged.

Drill Stem Tests Taken [X] Yes [] No
Samples Sent to Geological Survey [] Yes [X] No
Cores Taken [] Yes [X] No

Formation Description [] Log [X] Sample

DST 1 (4074-4095) 30-30-30 did not take FSI
1st op wk blo 20" 2nd op no blo fl tool no help
Rec 10' M IF 47-47 FF 47-47 ISI 70
DST 2 (4072-4112) 30-30-30-30 1st op wk blo 5"
2nd op no blo fl tool no help Rec 10'M
IF 47-47 FF 47-47 ISI 175 FSI 117
DST 3 (4110-4120) 60-30-60-30 strg blo off btm
bucket both ops Rec 543' MSW IF 47-117 FF 117-175
ISI 1195 FSI 1195.

Table with 3 columns: Name, Top, and Elevation. Rows include Anhydrite, Tarkio, Elmont, Topeka, Heebner, Toronto, Lansing, Base KC, Sand, Arbuckle, and RTD.

RTD 4120.

Plugged.

RELEASED CONFIDENTIAL OCT 03 1986

CASING RECORD, PERFORATION RECORD, TUBING RECORD, and METHOD OF COMPLETION sections with various data fields and checkboxes.

Disposition of gas: [] Vented [] Sold [] Used on Lease [] Open Hole [] Perforation [] Other (Specify) [] Dually Completed [] Coningled