


STATE OF KANSAS  
STATE CORPORATION COMMISSION

Give All Information Completely  
Make Required Affidavit  
Mail or Deliver Report to:  
Conservation Division  
State Corporation Commission  
800 Bittling Building  
Wichita, Kansas

WELL PLUGGING RECORD

NORTH

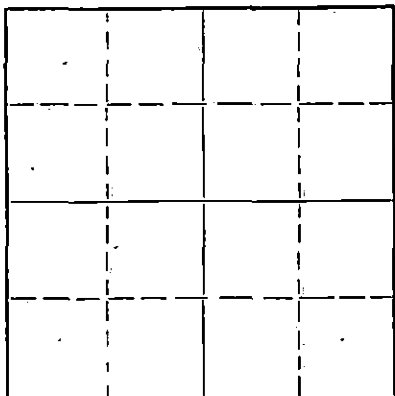

Locate well correctly on above  
Section Plat

Barton County. Sec. 6 Twp. 20 Rge. 14 (E) W (W)  
Location as "NE/CNW/SWK" or footage from lines SW SW SE  
Lease Owner Shelley-Miller Drilling, Inc  
Lease Name Koelsch Well No. 1  
Office Address 205 Miller Bldg, Wichita, Kansas  
Character of Well (completed as Oil, Gas or Dry Hole) Dry Hole  
Date well completed May 24 19 53  
Application for plugging filed May 24 19 53  
Application for plugging approved May 24 19 53  
Plugging commenced May 24 19 53  
Plugging completed May 24 19 53  
Reason for abandonment of well or producing formation No Commercial Shows  
If a producing well is abandoned, date of last production \_\_\_\_\_ 19 \_\_\_\_  
Was permission obtained from the Conservation Division or its agents before plugging was commenced? Yes

Name of Conservation Agent who supervised plugging of this well C. D. Stough  
Producing formation \_\_\_\_\_ Depth to top \_\_\_\_\_ Bottom \_\_\_\_\_ Total Depth of Well 3637' Feet  
Show depth and thickness of all water, oil and gas formations.

OIL, GAS OR WATER RECORDS

CASING RECORD

FORMATION	CONTENT	FROM	TO	SIZE	PUT IN	PULLED OUT
				8 5/8"	880'	

Describe in detail the manner in which the well was plugged, indicating where the mud fluid was placed and the method or methods used in introducing it into the hole. If cement or other plugs were used, state the character of same and depth placed, from \_\_\_\_\_ feet to \_\_\_\_\_ feet for each plug set.

Top Plug @ 35' Cemented with 10 sacks  
Bottom Plug @ 270' Cemented with 20 sacks

RECEIVED  
STATE CORPORATION COMMISSION  
MAY 27 1953  
5-29-1953  
CONSERVATION DIVISION  
Wichita, Kansas

(If additional description is necessary, use BACK of this sheet)  
Name of Plugging Contractor \_\_\_\_\_  
Address \_\_\_\_\_

STATE OF KANSAS, COUNTY OF SEDGWICK, ss.  
R. A. Shelley (employee of owner) or (owner or operator) of the above-described well, being first duly sworn on oath, says: That I have knowledge of the facts, statements, and matters herein contained and the log of the above-described well as filed and that the same are true and correct. So help me God.

(Signature) Richard A. Shelley  
205 Miller Bldg, Wichita, Kansas  
(Address)

SUBSCRIBED AND SWORN to before me this 28 day of May 19 53

My commission expires March 24, 1956 Notary Public.

24-2675-5 2-52-20M

PLUGGING  
FILE SEC 6 T 20 R 14 W  
BOOK PAGE 103 LINE 40

COMPANY: Shelley-Miller Drilling, Inc  
205 Miller Building  
Wichita, Kansas

Rotary Drilling Commenced: 5-14-53  
Rotary Drilling Completed: 5-24-53

LOCATION: Koelsch #1  
SW SW SE 6-20S-14W  
Barton County, Kansas

CONTRACTOR: Shelley-Miller Drilling, Inc  
205 Miller Building  
Wichita, Kansas

CASING RECORD: 8-5/8" 24# Slms. Casing Set @ 880'  
Cemented with 125 sacks of cement

# L O G

(Measurements from Top of Rotary Bushing to Bottom of formation)

Clay & Sand	225	
Clay & Shale	310	
Sand	395	
Red Bed	450	
Sand & Shale	500	
Shale	765	
Red Bed	862	
Anhydrite	890	
Shale	960	
Shale & Shells	1340	
Shale	1650	
Lime & Shale	1720	
Lime	2065	
Lime & Shale	3115	
Lime	3160	
Lime & Shale	3325	
Lime	3637	Rotary T. D.

The undersigned, Richard A. Shelley, President of Shelley-Miller Drilling, Inc., hereby certifies in behalf of said company, that the above log is a true and correct log of the formation encountered in drilling the above well as reflected by the Daily Drilling Reports.

**RECEIVED**  
STATE CORPORATION COMMISSION

MAY 29 1953

SHELLEY MILLER DRILLING, INC

By

*Richard A. Shelley*  
President

CONSERVATION DIVISION

STATE OF KANSAS )  
COUNTY OF SEDGWICK ) SS Wichita, Kansas

BE IT REMEMBERED that on this 28th day of May, 1953, before me, the undersigned, a Notary Public, duly commissioned in and for the county and state aforesaid, came Richard A. Shelley, President, and known to me to be the same person who executed the foregoing instrument of writing in behalf of Shelley-Miller Drilling, Inc., as President of said company, and he duly acknowledged the execution of the same for himself and for said company.

IN WITNESS WHEREOF, I have hereunto set my hand and official seal on the day and year last above written.

*Louise M. Baker*  
Notary Public

My Commission Expires:  
March 24, 1956

