


WELL PLUGGING RECORD

Give All Information Completely
Make Required Affidavit
Mail or Deliver Report to:
Conservation Div.
State Corporation Commission
800 Bitting Building
Wichita, Kansas

Barton County, Sec. 17 Twp. 20 Rge. 14 (E) (W)

Location as "NE/CNW $\frac{1}{4}$ SW $\frac{1}{4}$ " or footage from lines SE SE NE
Lease Owner Solar Oil Corporation
Lease Name Tobias H. Boese Well No. 1
Office Address 1117 Union Nat'l. Bk. Bld., Wichita 2, Kansas
Character of Well (completed as Oil, Gas or Dry Hole) Dry Hole
Date well completed May 22, 1952
Application for plugging filed May 22, 1952
Application for plugging approved May 22, 1952
Plugging commenced May 22, 1952
Plugging completed May 22, 1952
Reason for abandonment of well or producing formation

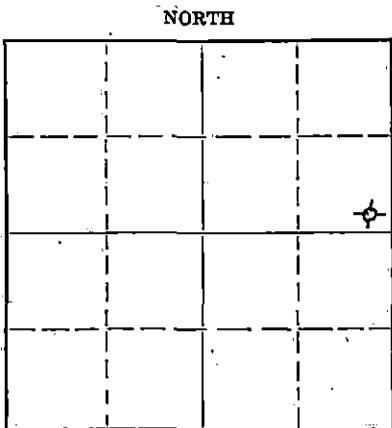

Locate well correctly on above Section Plat.

If a producing well is abandoned, date of last production 19
Was permission obtained from the Conservation Division or its agents before plugging was commenced? Yes

Name of Conservation Agent who supervised plugging of this well C. D. Stough
Producing formation Depth to top Bottom Total Depth of Well 3627 Feet
Show depth and thickness of all water, oil and gas formations.

OIL, GAS OR WATER RECORDS

CASING RECORD

Formation	Content	From	To	Size	Put In	Pulled Out
				8 5/8	842'	None

Describe in detail the manner in which the well was plugged, indicating where the mud fluid was placed and the method or methods used in introducing it into the hole. If cement or other plugs were used, state the character of same and depth placed, from 3627 feet to surface feet for each plug set.

Pumped hole full of heavy mud - set 8 5/8" bridging plug at 300'
20 sacks cement through drill pipe - mud to 35' - another plug @ 35'
and 10 sacks cement.

(If additional description is necessary, use BACK of this sheet)

Name of Plugging Contractor Quaker Drilling Company, Inc.
Address 300 Bitting Building, Wichita, Kansas

STATE OF KANSAS, COUNTY OF SEDGWICK, SS.
James Davis, Jr. (employee of owner) or (owner or operator) of the above-described well,

being first duly sworn on oath, says: That I have knowledge of the facts, statements, and matters herein contained and the log of the above-described well as filed and that the same are true and correct. So help me God.

(Signature) James Davis Jr.
Wichita, Kansas (Address)

SUBSCRIBED AND SWORN to before me this 27th day of May, 1952.

My commission expires July 27, 1955 STATE CORPORATION COMMISSION 23-8390-3 6-51-50M

Leta Lee Miller Notary Public.

RECEIVED
MAY 28 1952
PLUGGING
FILE SEC 17 T 20 CONSERVATION DIVISION
BOOK PAGE 18 LINE 3 Wichita, Kansas

5-28-1952

WELL LOG

SOLAR OIL COMPANY

Elevation: 1900 DF

Contractor: Quaker Drilling Co., Inc.

Commenced: 5-8-52

Boese No. 1
SE SE NE Sec. 17-20S-14W
Barton County, Kansas

Completed: 5-22-52

Production: D & A

Casing Record:

Set 842' of 8 5/8" with 450 sacks cement

(Figures indicate bottom of formation)

<u>FORMATION:</u>	<u>DEPTH</u>
Surface Clay & Sand	140
Shale	280
Sand and Shale	370
Sand, Red Bed & Shale	385
Red Bed and Shale	832
Anhydrite	958
Red Bed and Shale	1200
Shale and Shells	1380
Lime and Shale	1650
Lime	1850
Lime and Shale	2020
Lime	2075
Lime and Shale	2175
Lime	2385
Lime and Shale	2690
Lime	2730
Lime and Shale	2870
Lime	3195
Lime and Shale	3322
Lime	3627 T.D.


I hereby certify that the above is a true and correct copy of Driller's Log of well drilled in the SE SE NE of Section 17, Township 20 South, Range 14 West, Barton County, Kansas.

QUAKER DRILLING CO., INC.

By: Harold M. M. Cull
PresidentSubscribed and sworn to before me this 26 day of May, 1952.Jo Ann Beard
Notary Public

My Commission Expires:

March 7, 1955

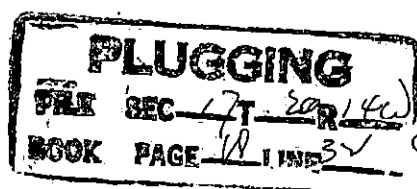RECEIVED
STATE CORPORATION COMMISSION

MAY 28 1952

CONSERVATION DIVISION
Wichita, Kansas