

STATE OF KANSAS
STATE CORPORATION COMMISSION
CONSERVATION DIVISION
P. O. BOX 17027
WICHITA, KANSAS 67217


FORM CP-4

WELL PLUGGING RECORD

Barton County, Sec. 30 Twp. 20S Rge. 11W (W)

Location as "NE/CNW/SW" or footage from lines C NE SE NE
Lease Owner T. T. & A Drilling Company and Poor Boy Corporation
Lease Name Weathers #1 Well No. 1
Office Address Route 2, Great Bend, Kansas 67530
Character of Well (completed as Oil, Gas or Dry Hole) Dry Hole
Date well completed January 26, 1976 19
Application for plugging filed January 26, 1976 19
Application for plugging approved January 26, 1976 19
Plugging commenced 8:45 AM, January 26, 1976 19
Plugging completed 10:15 AM, January 26, 1976 19
Reason for abandonment of well or producing formation Dry Hole

NORTH

 

Locate well correctly on above Section Plot

If a producing well is abandoned, date of last production 19
Was permission obtained from the Conservation Division or its agents before plugging was commenced? Yes

Name of Conservation Agent who supervised plugging of this well Duane L. Pankin
Producing formation _____ Depth to top _____ Bottom _____ Total Depth of Well 3658'
Show depth and thickness of all water, oil and gas formations.

OIL, GAS OR WATER RECORDS

CASING RECORD

FORMATION	CONTENT	FROM	TO	SIZE	PUT IN	PULLED OUT
				8 5/8"	870'	None

Describe in detail the manner in which the well was plugged, indicating where the mud fluid was placed and the method or methods used in introducing it into the hole. If cement or other plugs were used, state the character of same and depth placed, from _____ feet to _____ feet for each plug set.

Filled hole with heavy mud.
Pumped through Open Ended Drill pipe 25 sacks at 870'.
Pumped through Open Ended Drill pipe 25 sacks at 300'.
Filled hole to 40' - Plug and 1/4 sack hulls for solid
bridge. 10 sacks to surface - 2 sacks for rathole.

(If additional description is necessary, use BACK of this sheet)
Name of Plugging Contractor Sterling Drilling Company
Address P. O. Box 129, Sterling, Kansas 67579

STATE OF KANSAS COUNTY OF RICE
F. A. Mueller (employee of owner) or (owner or operator) of the above-described

well, being first duly sworn on oath, says: That I have knowledge of the facts, statements, and matters herein contained and the log of the above-described well as filed and that the same are true and correct. So help me God. STERLING DRILLING COMPANY

(Signature) F. A. Mueller, Secretary
P. O. Box 129, Sterling, Kansas 67579
(Address)

SUBSCRIBED AND SWORN TO before me this 27th day of January, 1976

My commission expires _____ Charles M. Hall, Notary Public

RECEIVED
STATE CORPORATION COMMISSION
FEB 9 1976
CONSERVATION DIVISION
Wichita, Kansas

STERLING DRILLING COMPANY
P. O. Box 129
Sterling, Kansas 67579

WELL LOG ----- WEATHERS #1
Located: C NE SE NE, Section 30-20S-14W, Barton County,
Kansas

OWNER: Poor Eoy Corporation and T. T. & A. Drilling Company
ROTARY DRILLING CONTRACTOR: Sterling Drilling Company

COMMENCED: January 18, 1976
COMPLETED: January 26, 1976

TOTAL DEPTH: 3658'

<u>LOG</u>		<u>CASING RECORD</u>
0 -	100 Sand and Shale	Ran 22 joints 8 5/8", 28#, 8V, Range #3 used casing, 851.45' set at 874' K.B. with 300 sacks 50/50 Pozmix, 3% cc, 2% gel, followed with 200 sacks Common, 3% cc. Plug down at 11:45 AM, 1-19-76.
100 -	440 Shale	
440 -	500 D. Sand	
500 -	780 Shale and Red Bed	
780 -	866 Red Bed	
866 -	886 Anhydrite	
886 -	1610 Shale	
1610 -	2134 Shale and Shells	
2134 -	3340 Lime and Shale	
3340 -	3460 Lime	
3460 -	3620 Lime and Shale	Plugged.
3620 -	3636 Arbuckle	
3636 -	3658 Arbuckle, Lime and Shale	

RECEIVED
STATE OCCUPATION COMMISSION

FEB 9 1976

CONSERVATION DIVISION
Wichita, Kansas