


WELL PLUGGING RECORD

Give All Information Completely
Make Required Affidavit
Mail or Deliver Report to:
Conservation Division
State Corporation Commission
800 Bitting Building
Wichita, Kansas

NORTH

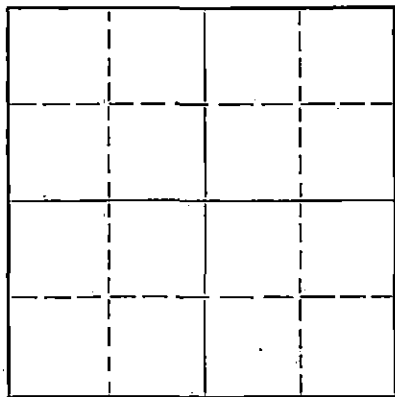

Locate well correctly on above
Section Plat

Barton County, Sec. 29 Twp. 20 Rge. 14W (E) (W)

Location as "NE/CNW $\frac{1}{4}$ /SW $\frac{1}{4}$ " or footage from lines SE $\frac{1}{4}$ SE $\frac{1}{4}$ SE $\frac{1}{4}$
Lease Owner Adkins Drilling Company, Inc.
Lease Name Christianson Well No. 1
Office Address Great Bend, Kansas
Character of Well (completed as Oil, Gas or Dry Hole) Dry Hole
Date well completed 5-11-1953 19
Application for plugging filed 5-11-1953 19
Application for plugging approved 5-11-1953 19
Plugging commenced 5-11-1953 19
Plugging completed 5-11-1953 19
Reason for abandonment of well or producing formation Dry Hole

If a producing well is abandoned, date of last production 19
Was permission obtained from the Conservation Division or its agents before plugging was commenced? Yes

Name of Conservation Agent who supervised plugging of this well C. D. Stough
Producing formation Depth to top Bottom Total Depth of Well 3697 Feet
Show depth and thickness of all water, oil and gas formations.

OIL, GAS OR WATER RECORDS

CASING RECORD

Formation	Content	From	To	Size	Put In	Pulled Out
Sand & Shale	0	0	325	8 5/8"	221'	None

Describe in detail the manner in which the well was plugged, indicating where the mud fluid was placed and the method or methods used in introducing it into the hole. If cement or other plugs were used, state the character of same and depth placed, from feet to feet for each plug set.

Pits were jetted and heavy mud pumped into hole and permanent plug set @ 221', 30 bbls of heavy mud pumped into hole and cemented with 75 sacks of cement to surface by Globe Cementing Company of Great Bend, Kansas.

Name of Plugging Contractor Adkins Drilling Company, Inc.
Address Great Bend, Kansas
(If additional description is necessary, use BACK of this sheet)

STATE CORPORATION COMMISSION
MAY 15 1953
5-15-1953

STATE OF Kansas, COUNTY OF Barton, ss.
Jim Adkins (employee of owner) or (owner or operator) of the above-described well,
being first duly sworn on oath, says: That I have knowledge of the facts, statements, and matters herein contained and the log of the above-described well as filed and that the same are true and correct. So help me God.

(Signature) *Jim Adkins*
1502- 12th St. Great Bend, Kansas.
(Address)

SUBSCRIBED AND SWORN to before me this 14th day of May, 1953.

My commission expires 2-29-1956. *Pauline B. Adkins* Notary Public.

PLUGGING
FILE SEC 29 T 20 R 14 W
BOOK PAGE 101 LINE 13

Drillers Log

Lease Owner- Isern-Angle & Adkins

Lease- Christianson No. 1

Location SE $\frac{1}{4}$ SE $\frac{1}{4}$ SE $\frac{1}{4}$ Sec. 29-20-14W. Barton County, Kansas.

Contractor- Adkins Drilling Company, Inc. Great Bend, Kansas.

Formation	To	From	Formation	To	From
Sand	0	170			
Shale	170	275			
Shale & Sand	275	325			
Dakota Sand and Red Bed	325	407			

Set 8 5/8" @ 221' cemented with 200 sacks cement and 200 lbs Calcium Chloride.

Plug & Cement	198	225
Open Hole	225	407
Sand & Red Bed	407	500
Shale & Red Bed	500	865
Anhydrite	865	885
Shale	885	1600
Shale & Lime	1600	2110
Lime & Shale	2110	2285
Shale & Lime	2285	2515
Lime & Shale	2515	2630
Shale & Lime	2630	3225
Lime & Shale	3225	3287
Lime	3287	3415
Lime & Shale	3415	3479
Lime	3479	3545
Lime & Shale	3545	3610
Lime	3610	3650
Conglomerite	3650	3674
Lime	3674	3697

Total Depth 3697'

Dry & Abandoned at 3697'

I do solemnly swear that the foregoing is a true and correct copy of the Drillers Log on above well.

Jim Adkins

Subscribed and sworn to before me this 13th day of May 1953.

Pauline B. Adkins
Notary Public

My Commission expires
2-29-1956

RECEIVED
STATE CORPORATION COMMISSION
MAY 15 1953
CONSTITUTION

PLUGGING
FILE SEC 29-20-14W
BOOK PAGE 101 LINE 13