


STATE OF KANSAS
STATE CORPORATION COMMISSION

WELL PLUGGING RECORD

Give All Information Completely
Make Required Affidavit
Mail or Deliver Report to
Conservation Division
State Corporation Comm.
245 North Water
Wichita, KS 67202

Barton County. Sec. 24 Twp. 20SRge. 14W R/W
Location as "NE/CNW/SW" or footage from lines _____
C - NE SW NW
Lease Owner H-30, INC.
Lease Name Maybach Well No. 1
Office Address 200 N. Main Wichita, Kansas 67202
Character of Well (Completed as Oil, Gas or Dry Hole) _____
Dry Hole
Date Well completed August 6, 1976
Application for plugging filed Verbal Application 19
Application for plugging approved Verbal Approval 19
Plugging commenced August 6, 1976
Plugging completed August 6, 1976
Reason for abandonment of well or producing formation _____

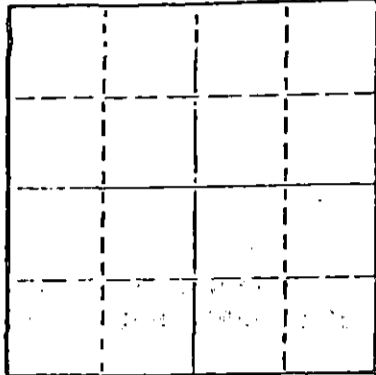

Locate well correctly on above
Section Plot

If a producing well is abandoned, date of last production _____ 19____
Was permission obtained from the Conservation Division or
its agents before plugging was commenced? yes

Name of Conservation Agent who supervised plugging of this well Duane Rankin
Producing formation _____ Depth to top _____ Bottom _____ Total Depth of Well 3,550'
Show depth and thickness of all water, oil and gas formations.

OIL, GAS OR WATER RECORDS

CASING RECORD

FORMATION	CONTENT	FROM	TO	SIZE	PUT IN	PULLED OUT
				8 5/8"	249'	none

Describe in detail the manner in which the well was plugged, indicating where the mud fluid was placed and the method or methods used in introducing it into the hold. If cement or other plugs were used, state the character of same and depth placed, from _____ feet to _____ feet for each plug set.

Squeezed with 120 sacks cement.

RECEIVED
STATE CORPORATION COMMISSION

AUG 16 1976

CONSERVATION DIVISION
Wichita, Kansas

(If additional description is necessary, use BACK of this sheet)


Name of Plugging Contractor Halliburton Services
410 Union Center Bldg. Wichita, Kansas 67202

STATE OF Kansas COUNTY OF Sedgwick ss:
Dean Britting - Agent (employee of owner) or (lessee or operator) of the above-described

well, being first duly sworn on oath, says: That I have knowledge of the facts, statements, and matters herein contained and the log of the above-described well as filed and that the same are true and correct. So help me God.

(Signature) Dean Britting
200 N. Main Wichita, Kansas 67202

Subscribed and sworn to before me this 13th day of August, 19 76

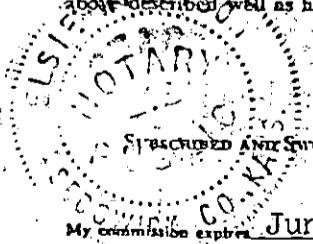

My commission expires June 30, 1978

Elsie Willison
Elsie Willison - Notary Public.

API # 15-009-21,061.0000

KANSAS GEOLOGICAL SOCIETY
KANSAS WELL LOG BUREAU - KANSAS WELL SAMPLE BUREAU
KANSAS GEOLOGICAL SOCIETY BUILDING
508 EAST MURDOCK - WICHITA, KANSAS

COMPANY H-30, INC.

SEC. 24 T. 20S R. 14W
LOC. C - NE SW NW

FARM Maybach

NO. 1

COUNTY Barton

TOTAL DEPTH 3,550'

COMM. July 30, 1976


COMP. August 6, 1976

SHOT OR TREATED

CONTRACTOR H-30, INC.

ISSUED August 13, 1976

KANSAS

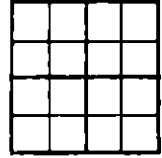

CASING

20	10		
15	8	5/8" 249' cemented w/250 sxs cement	ELEVATION 1894 KB
12	6		
13	5		PRODUCTION

FIGURES INDICATE BOTTOM OF FORMATIONS

Sand and Shale	250'
Shale	804'
Anhydrite	812'
Shale	1,864'
Lime and Shale	2,670'
Lime	2,987'
Lime and Shale	3,061'
Lime	3,550'
Total Rotary Depth	3,550'

RECEIVED
STATE CORPORATION COMMISSION

AUG 16 1976

CONSERVATION DIVISION
Wichita, Kansas

I hereby certify the above and foregoing to be a true and correct log of the above described well as shown by the drilling reports.


H-30, INC.

Dean Britting

Dean Britting

State of Kansas }
County of Sedgwick } SS:

Subscribed and Sworn to before me a Notary Public in and for said county and state this 13th day of August, 1976.

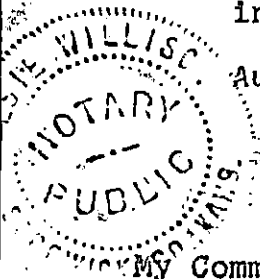

Elsie Willison

Elsie Willison - Notary Public

My Commission Expires:

June 30, 1978