

STATE OF KANSAS
STATE CORPORATION COMMISSION


Form CP-4

Give All Information Completely
Make Required Affidavit
Mail or Deliver Report to:
Conservation Division
State Corporation Commission
212 No. Market
Wichita, Kansas 67202

WELL PLUGGING RECORD

Barton County. Sec. 24 Twp. 20 Rge. (E) 14 (W)

Location as "NE/CNW/SW" or footage from lines NW SW NW
Lease Owner Clinton Oil Company
Lease Name Maybach V Well No. 1
Office Address 217 N. Water, Wichita, Kansas 67202
Character of Well (completed as Oil, Gas or Dry Hole) oil
Date well completed _____ 19____
Application for plugging filed _____ 19____
Application for plugging approved _____ 19____
Plugging commenced March 22 19 72
Plugging completed April 10 19 72
Reason for abandonment of well or producing formation depleted

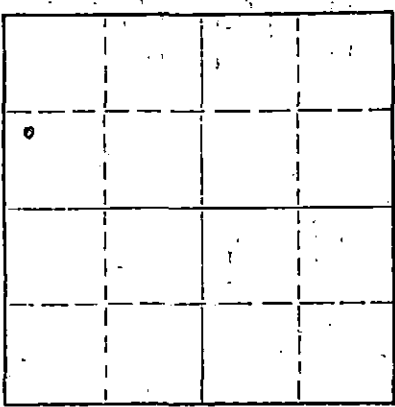

Locate well correctly on above
Section Plot

If a producing well is abandoned, date of last production _____ 19____
Was permission obtained from the Conservation Division or its agents before plugging was commenced? yes

Name of Conservation Agent who supervised plugging of this well Donald Truan
Producing formation _____ Depth to top _____ Bottom _____ Total Depth of Well 3600 Feet
Show depth and thickness of all water, oil and gas formations.

OIL, GAS OR WATER RECORDS

CASING RECORD

FORMATION	CONTENT	FROM	TO	SIZE	PUT IN	PULLED OUT
		0	245'	8 5/8"	245'	none
		0	3599'	5 1/2"	3599'	2325.25'

Describe in detail the manner in which the well was plugged, indicating where the mud fluid was placed and the method or methods used in introducing it into the hole. If cement or other plugs were used, state the character of same and depth placed, from _____ feet to _____ feet for each plug set.

Sanded back to 3240' and dumped 5 sacks of cement.
Squeezed well with 3 sacks of hulls, 20 sacks of mud and 100 sacks of cement.

RECEIVED
STATE CORPORATION COMMISSION
APR 18 1972
CONSERVATION DIVISION
Wichita, Kansas

Name of Plugging Contractor PIPE PULLERS, INC.
Address Box 486, Ellinwood, Kansas 67526

STATE OF KANSAS COUNTY OF BARTON, ss.
Evelyn Roth (employee of owner) or (owner or operator) of the above-described

well, being first duly sworn on oath, says: That I have knowledge of the facts, statements, and matters herein contained and the log of the above-described well as filed and that the same are true and correct. So help me God.

(Signature) Evelyn Roth
Ellinwood, Kansas (Address)

SUBSCRIBED AND SWORN TO before me this 11 day of April, 1972

My commission expires Feb. 10, 1975
George A. Meyer Notary Public.

WELL LOG

15.009.206+2.0000

COMPANY **Clinton Oil Company**
 FARM **Maybach** NO. **1-V**
 TOTAL DEPTH **3600'**
 COMM. **11-21-71** COMP. **12-3-71**
 CONTRACTOR **Carvey Drilling Company**

SEC. **24** T. **20S** R. **14W**
 LOC. **NW SW NW**
 COUNTY **Barton, Kansas**

CASING
 8 5/8" @ 245' w/275oz
 5 1/2" @ 3599' w/200oz

ELEVATION **1890 GL**

PRODUCTION

FIGURES INDICATE BOTTOM OF FORMATIONS

- 245' Sand & Shale
- 325' Shale
- 365' Hard Sand
- 795' Red Bed & Shale
- 820' Anhydrite
- 1175' Red Bed & Shale
- 1550' Shale
- 1710' Lime & Shale
- 2220' Lime
- 2320' Lime & Shale
- 2640' Shale
- 2810' Shale & Shells
- 2980' Lime & Shale
- 3090' Lime
- 3258' Lime & Shale
- 3345' Lime
- 3532' Arbuckle
- 3539' Lime
- 3545' Arbuckle
- 3558' Lime
- 3563' Arbuckle
- 3600' Arbuckle
- 3600' EFD

RECEIVED
 STATE CORPORATION COMMISSION
 JAN 14 1972
 CONSERVATION DIVISION
 Wichita, Kansas

State of Kansas }
 County of Barton } SS

I, Charles Marker of Carvey Drilling Company
 upon oath state the above and foregoing is a true and correct copy of the log of the Maybach No. 1-V well.

Charles Marker

Subscribed and sworn to before me this 6th day of December 19 71

My Commission Expires: July 2, 1974

Lawrence A. [Signature]
 NOTARY PUBLIC