

STATE OF KANSAS
STATE CORPORATION COMMISSION
200 Colorado Derby Bldg.
Wichita, Kansas 67202

WELL PLUGGING RECORD

Give All Information Completely
Make Required Affidavit

COUNTY Barton SEC. 22 TWP. 20 RGE. 14 E/W
Location as in quarters or footage from lines:
NE/SE/SE

Locate Well
correctly on above
Section Platt.

Lease Owner Kimbark Oil & Gas Company
Lease Name Neff Well No. #1
Office Address P. O. Box 1516 - Dodge City, Ks. 67801
Character of Well (Completed as Oil, Gas or Dry Hole): Oil
Date Well Completed _____
Application for plugging filed _____
Plugging commenced February 17, 1983
Plugging completed March 10, 1983
Reason for abandonment of well or producing formation
Depleted.

Was permission obtained from the Conservation Division or it's
Agent's before plugging was commenced? Yes

Name of Conservation Agent who supervised plugging of this well Carl Goodrow
Producing formation _____ Depth to top _____ bottom T.D. 3565'
Show depth and thickness of all water, oil and gas formations.

OIL, GAS OR WATER RECORDS

Casing Record

Formation	Content	From	To	Size	Put in	Pulled Out
				8 5/8"	825'	NONE
				5 1/2"	3535'	2764.20'

Describe in detail the manner in which the well was plugged, indicating where the mud
fluid was placed and the method or methods used in introducing it into the hold. If cement
or other plugs were used, state the character of same and depth placed, from _____ feet
to _____ feet for each plug set.

Dumped five (5) sacks cement on bottom, sanded to 3495' and
dumped five (5) sacks cement.
Shot pipe @ 2730'.
Pulled sixty-six (66) joints 5 1/2" casing.
Squeezed well with four (4) sacks hulls, nine (9) sacks gel,
twenty-five (25) sacks 50/50 pozmix cement with 4% added gel and
3% calcium chloride and six (6) sacks gel. Released plug and
pumped one hundred forty (140) sacks cement at 800 psi shut in.

(If additional description is necessary, use BACK of this sheet)

Name of Plugging Contractor Rockhold Engineering, Inc.

STATE OF KANSAS COUNTY OF BARTON, ss.
James W. Rockhold (employee of owner) or (owner or operator) of the
above-described well, being first duly sworn on oath, says: That I have knowledge of the
facts, statements, and matters herein contained and the log of the above-described well as
filed and that the same are true and correct. So help me God.

(Signature) James W. Rockhold
JAMES W. ROCKHOLD - Box 698 - Great Bend, Ks.
(Address) 67530

SUBSCRIBED AND SWORN TO before me this 15th day of March, 1983



My Commission expires:

Margaret Prosser
Notary Public.
RECEIVED
STATE CORPORATION COMMISSION
3-16-1983
MAR 16 1983

WELL LOG

15.009.22610.0000

COMPANY Kimbark Oil & Gas Company

BEC. 22 T. 20S R. 14W

FARM Neff NO. 1


LOC. NE SE SE

TOTAL DEPTH 3566 RTD

COUNTY Barton, Ks

COMM. 12-26-81 COMP. 1-2-82

CONTRACTOR DaMac Drilling Inc.

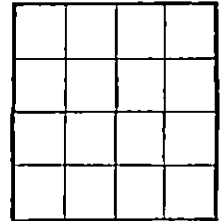

CASING 8 5/8 set @ 825'

ELEVATION

PRODUCTION 5 1/2 set @ 3535'

FIGURES INDICATE BOTTOM OF FORMATIONS

Sand, Shale, RedBed	0	1434
Shale	1434	1980
Lime, Shale	1980	3566 RTD

RECEIVED
STATE CORPORATION COMMISSION

FEB 4 1983

REGISTRATION DIVISION
Wichita, Kansas

State of Kansas }
County of Barton } ES


I, Martha J. McKown of DaMac Drilling Inc.

upon oath state the above and foregoing is a true and correct copy of the log of the Neff No. 1 well.

Martha J. McKown

Subscribed and sworn to before me this 4th day of January 1982

My Commission Expires:

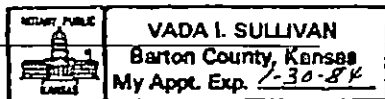

Vada I. Sullivan
NOTARY PUBLIC