


STATE OF KANSAS
STATE CORPORATION COMMISSION
Give All Information Completely
Make Required Affidavit
Mail or Deliver Report to:
Conservation Division
State Corporation Commission
211 No. Broadway
Wichita, Kansas

WELL PLUGGING RECORD

NORTH

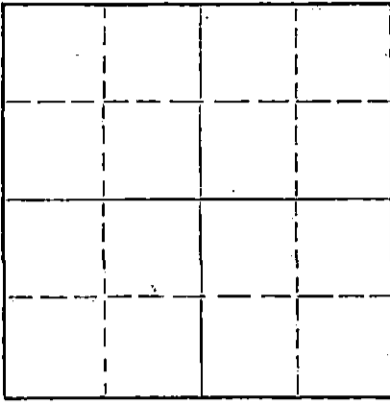

Locate well correctly on above
Section Plat

Barton County, Sec. 15 Twp. 20S Rge. 13W (E) (W)
Location as "NE/CNW%SW%" or footage from lines SW SE SE
Lease Owner ALPINE OIL & ROYALTY CO., INC.
Lease Name VOIGHT Well No. 2
Office Address 1100 Bitting Building, Wichita, Kansas
Character of Well (completed as Oil, Gas or Dry Hole) Dry Hole
Date well completed March 14, 1958 19
Application for plugging filed March 14, 1958 19
Application for plugging approved March 14, 1958 19
Plugging commenced March 14, 1958 19
Plugging completed March 14, 1958 at 5 P. M. 19
Reason for abandonment of well or producing formation non-productive in commercial quantities
If a producing well is abandoned, date of last production _____ 19
Was permission obtained from the Conservation Division or its agents before plugging was commenced? Yes

Name of Conservation Agent who supervised plugging of this well Donald Truan
Producing formation _____ Depth to top _____ Bottom _____ Total Depth of Well 3513 Feet
Show depth and thickness of all water, oil and gas formations.

OIL, GAS OR WATER RECORDS

CASING RECORD

FORMATION	CONTENT	FROM	TO	SIZE	PUT IN	PULLED OUT
				8 5/8"	198'	Cemented

Describe in detail the manner in which the well was plugged, indicating where the mud fluid was placed and the method or methods used in introducing it into the hole. If cement or other plugs were used, state the character of same and depth placed, from _____ feet to _____ feet for each plug set.

Heavy mud from Total Depth - 3513 feet - to surface
Solid plug of Hulls and wood at 190 feet and 25 sacks
cement through drill pipe - then heavy mud to 40 feet
another plug same as before with 10 sacks cement to
base of cellar

RECEIVED
MAR 16 1958
CONSERVATION DIVISION
Wichita, Kansas

3-18-1958

(If additional description is necessary, use BACK of this sheet)

Name of Plugging Contractor Quaker Drilling Co., Inc.
Address 1100 Bitting Building, Wichita, Kansas

STATE OF Kansas, COUNTY OF Sedgwick, ss.
Dwight J. Wilson (employee of owner) or (owner or operator) of the above-described well, being first duly sworn on oath, says: That I have knowledge of the facts, statements, and matters herein contained and the log of the above-described well as filed and that the same are true and correct. So help me God.

(Signature) Dwight J. Wilson
1100 Bitting Building, Wichita, Kansas
(Address)

SUBSCRIBED AND SWORN TO before me this 17th day of March, 19 58

Virginia Murrell
Notary Public.

My commission expires August 10, 1961

PLUGGING
FILE SEC. 15 T. 20 R. 13
BOOK PAGE 89 LINE 12

WELL LOG

ALPINE OIL & ROYALTY CO., INC.

Commenced: March 6, 1958

Contractor: Quaker Drilling Co., Inc.

Completed: March 14, 1958

Voight No. 2
SW SE SE Sec. 15-20S-13W
Barton County, Kansas

Elevation: 1874 KB

Production: D. & A.

Casing Record:

Set 8 5/8" casing at 198 feet with 200 sacks pozmix

(Figures Indicate the Bottom of the Formations)


<u>FORMATION</u>	<u>DEPTH</u>	<u>FORMATION TOPS</u>
Sand	105	Anhydrite 710
Hard Sand	134	Heebner 3103 -1229
Shale and Shells	198	Brown Lime 3218 -1344
Sand and Streaks of Shale	290	Lansing 3231 -1357
Red Bed and Shells	710	Base of Kansas City 3450 -1576
Anhydrite	735	Conglomerate 3465 -1591
Shale and Shells	1700	Rotary Total Depth 3513 -1639
Sandy Lime and Shale	1830	
Shale	2030	
Shale and Lime	2230	
Shale and Shells	2420	
Shale	2620	
Lime and Shale	2855	
Shale and Lime	2935	
Lime and Shale	3485	
Shale	3513	

We hereby certify the foregoing to be a true and correct copy of the Driller's Log of the well drilled in the SW SE SE of Section 15, Township 20 South, Range 13 West, Barton County, Kansas.

QUAKER DRILLING CO., INC.

By: 

SUBSCRIBED AND SWORN TO before me a Notary Public in and for Sedgwick County, Kansas this 17th day of March, 1958.

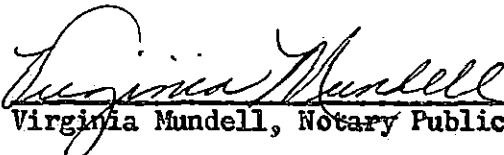
Virginia Mundell, Notary Public

MY COMMISSION EXPIRES:
August 10, 1961

RECEIVED
STATE CORPORATION COMMISSION

MAR 18 1958

CONSERVATION DIVISION
Wichita, Kansas

PLUGGING
FILE: SEC 15 T 20 R 13 W
BOOK PAGE 89 LINE 10