


WELL PLUGGING RECORD

Give All Information Completely
Make Required Affidavit
Mail or Deliver Report to:
Conservation Division
State Corporation Commission
211 No. Broadway
Wichita, Kansas

Barton County, Sec. 27 Twp. 20S Rge. (E) 14 (W)

NORTH

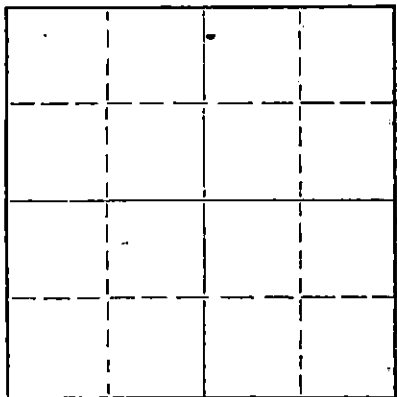

Locate well correctly on above
Section Plat

Location as "NE/CNW/SW" or footage from lines SW SW NE
Lease Owner Musgrove Drilling Company
Lease Name JETTIE RUSSELL Well No. 1
Office Address 801 Union Center, Wichita, Kansas
Character of Well (completed as Oil, Gas or Dry Hole) Dry
Date well completed December 31, 19 61
Application for plugging filed verbally - December 30, 19 61
Application for plugging approved verbally - December 30, 19 61
Plugging commenced December 31, 19 61
Plugging completed December 31, 19 61
Reason for abandonment of well or producing formation Dry

If a producing well is abandoned, date of last production 19
Was permission obtained from the Conservation Division or its agents before plugging was commenced? verbally - yes.

Name of Conservation Agent who supervised plugging of this well
Producing formation Depth to top Bottom Total Depth of Well Feet
Show depth and thickness of all water, oil and gas formations.

OIL, GAS OR WATER RECORDS CASING RECORD

FORMATION	CONTENT	FROM	TO	SIZE	PUT IN	PULLED OUT
				8-5/8"	600'	none

Describe in detail the manner in which the well was plugged, indicating where the mud fluid was placed and the method or methods used in introducing it into the hole. If cement or other plugs were used, state the character of same and depth placed, from feet to feet for each plug set.

Set 1st plug at 300' w/75 sx cement.
Set 2nd plug at 40' w/25 sx. cement.

1-8-1962

CONSERVATION DIVISION

JAN 8 1962

STATE CORPORATION COMMISSION

WICHITA, KANSAS

(If additional description is necessary, use BACK of this sheet)

Name of Plugging Contractor Musgrove Drilling Company
Address 801 Union Center, Wichita, Kansas

STATE OF Kansas, COUNTY OF Sedgwick, ss.

Emil E. Bowers (operator) or (owner or operator) of the above-described well, being first duly sworn on oath, says: That I have knowledge of the facts, statements, and matters herein contained and the log of the above-described well as filed and that the same are true and correct. So help me God.

(Signature) Emil E. Bowers

801 Union Center, Wichita, Kansas
(Address)

SUBSCRIBED AND SWORN to before me this 5th day of January, 19 62

My commission expires June 16, 1963

Leah Faye Hefke
Notary Public.

CONTRACTOR'S WELL LOG

COMPANY:	Musgrove Drilling Company
CONTRACTOR:	Musgrove Drilling Company
FARM:	JETTIE RUSSELL #1
LOCATION:	SW SW NE Sec. 27-20S-14W Barton County, Kansas
COMMENCED:	December 17, 1961
COMPLETED:	December 31, 1961

	0	251	Surface hole
	251	701	Surface soil and shale
	701	1665	Shale
	1665	3115	Lime & shale
	3115	3175	Lime
	3175	3347	Lime & shale
	3347	3415	Lime, shale & chert
	3415	3560	Lime & shale
	3560	3579	Sand, shale & lime
	3579	3630	Lime, shale & Arbuckle
		3630	Rotary Total Depth

Set 8-5/8" surface at 600 feet with 425 sacks Posmix.
 DRY & ABANDONED

ELECTRIC LOG TOPS:		ELEVATION:	1901' Gr. L.
Heebner	3193' (-1287)		1903' D. F.
Toronto	3210' (-1304)		1906' K. B.
Douglas	3227' (-1321)		
Brown Lime	3298' (-1392)		
Lansing	3309' (-1403)		
Simpson Sand	3350' (-1444)		
Arbuckle	3591' (-1685)		

STATE OF KANSAS)
) SS
 COUNTY OF SEDGWICK)

I, Emil E. Bowers, do hereby certify that the above and foregoing is a true and correct copy of the log of the JETTIE RUSSELL #1, SW SW NE of Section 27-20S-14W, Barton County, Kansas, as reflected by the files of Musgrove Drilling Company.

Emil E. Bowers
 Emil E. Bowers

Subscribed and sworn to before me, a Notary Public, in and for Sedgwick County, Kansas, this 5th day of January, 1962.

Leah Faye Hefke
 Leah Faye Hefke, Notary Public

My commission expires June 16, 1963.

RECEIVED
 STATE COMMISSION
 JAN 9 1962
 CONSERVATION DIVISION