


STATE OF KANSAS
STATE CORPORATION COMMISSION

Form CP-4

WELL PLUGGING RECORD

Give All Information Completely
Make Required Affidavit
Mail or Deliver Report to:
Conservation Division
State Corporation Commission
212 No. Market
Wichita, Kansas

NORTH

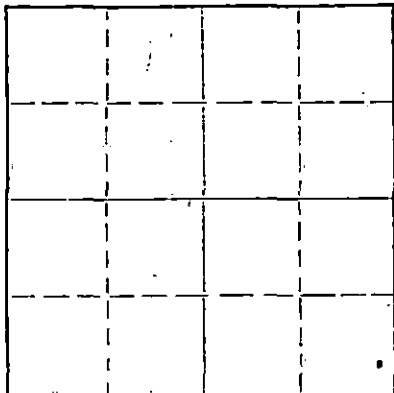

Locate well correctly on above
Section Plat

Rice County, Sec. 5 Twp. 20S Rge. 8W (W)
Location as "NE/CNW/SW" or footage from lines SE SE SE
Lease Owner Ben C. W. Hyde, Jr.
Lease Name EBRIGHT Well No. 1
Office Address 4722 Broadway, Kansas City, Missouri 64112
Character of Well (completed as Oil, Gas or Dry Hole) Dry Hole
Date well completed March 25 1967
Application for plugging filed March 25 1967
Application for plugging approved March 25 1967
Plugging commenced March 25 1967
Plugging completed March 25 1967
Reason for abandonment of well or producing formation Dry Hole

If a producing well is abandoned, date of last production 19
Was permission obtained from the Conservation Division or its agents before plugging was commenced? yes

Name of Conservation Agent who supervised plugging of this well Gilbert Toman
Producing formation Depth to top Bottom Total Depth of Well 3545 Feet
Show depth and thickness of all water, oil and gas formations.

OIL, GAS OR WATER RECORDS

CASING RECORD

FORMATION	CONTENT	FROM	TO	SIZE	PUT IN	PULLED OUT
Red Rock	RECEIVED STATE CORPORATION COMMISSION MAR 28 1967 CONSERVATION DIVISION Wichita, Kansas		250	8 5/8	247'	NONE

Describe in detail the manner in which the well was plugged, indicating where the mud fluid was placed and the method or methods used in introducing it into the hole. If cement or other plugs were used, state the character of same and depth placed, from feet to feet for each plug set.

Top plug 40'

Fill hole with mud to 225' and dumped 1/4 sacks hulls plug 25 sacks cement.

Fill hole with mud to 40' and dumped 1/4 sacks hulls plug 10 sacks cement.

2 sacks in Rat hole.

(If additional description is necessary, use BACK of this sheet)

Name of Plugging Contractor Isern Drilling Company
Address Box 486, Ellinwood, Kansas 67526

STATE OF KANSAS, COUNTY OF BARTON, ss.
W. F. Banks (employee of owner) or (owner or operator) of the above-described well, being first duly sworn on oath, says: That I have knowledge of the facts, statements, and matters herein contained and the log of the above-described well as filed and that the same are true and correct. So help me God.

(Signature) W. F. Banks
Box 486, Ellinwood, Kansas
(Address)

SUBSCRIBED AND SWORN to before me this 27th day of March, 1967

My commission expires February 10, 1971

George A. Meyer
Notary Public.

W E L L L O G

BEN C. W. Hyde, Jr., EBRIGHT #1
 SE SE SE, Section 5-20S-8W
 Rice County, Kansas

RECEIVED
 STATE CORPORATION COMMISSION
 APR 21 1967
 CONSERVATION DIVISION
 Wichita, Kansas

ELEVATION: 1669' GL; 1671' DF; 1673' KB.

Figures indicate bottom of formation:

PIPE RECORD:

8 5/8" set at 247'
 with 225 sacks cement.

0	to	10	cellar
		25	clay
		85	sand
		130	shale
		238	red rock
1100			shale & shells
1779			lime & shale
2432			shale & shells
2760			lime & shale
2860			shale
3210			lime & shale
3230			lime mixed with Chert
3350			lime & shale
3389			shale & lime
3501			lime & shale
3529			sand & shale
3545			shale & lime
3545			Rotary Total Depth

ROTARY COMMENCED: March 17, 1967
 ROTARY COMPLETED: March 25, 1967

TOPS:

Keebner	2720
Brown Lime	2859
Lansing	2895
Conglomerate Chert	3198
Kinderhook Lime	3312
Kinderhook Sand	3388
Maquoketa	3422
Viola	3461
Simpson Sand	3514
Log Total Depth	3545

STATE OF KANSAS) ss
 COUNTY OF BARTON)

I, W. F. Banks, Drilling Superintendent of Isean Drilling Company, contractor for the above-described well, being first duly sworn on oath, declare: That I have knowledge of the facts statements and matter herein contained pertaining to the log of the above-described well, as filed, and that the same are true and correct.

W. F. Banks
 W. F. Banks

Subscribed and sworn to before me on this 29th day of March, 1967.

George A. Meyer
 George A. Meyer, Notary Public

My commission expires February 10, 1971.