

WELL PLUGGING RECORD

Give All Information Completely  
Make Required Affidavit  
Mail or Deliver Report to:  
Conservation Division  
State Corporation Commission  
211 No. Broadway  
Wichita, Kansas

Rice County: Sec. 6 Twp. 20S Rge. 8 (E) 8 (W)

Location as "NE/CNW/SW" or footage from lines SE-SE-SE

Lease Owner Champlin Oil & Refining Co.

Lease Name Richardson - Smith Well No. 1

Office Address P.O. Box 308, Ellinwood, Kansas

Character of Well (completed as Oil, Gas or Dry Hole) Dry hole

Date well completed September 25 1964

Application for plugging filed September 24 1964

Application for plugging approved (Verbal) September 24 1964


Plugging commenced September 25 1964

Plugging completed September 25 1964

Reason for abandonment of well or producing formation

If a producing well is abandoned, date of last production 19

Was permission obtained from the Conservation Division or its agents before plugging was commenced? Yes

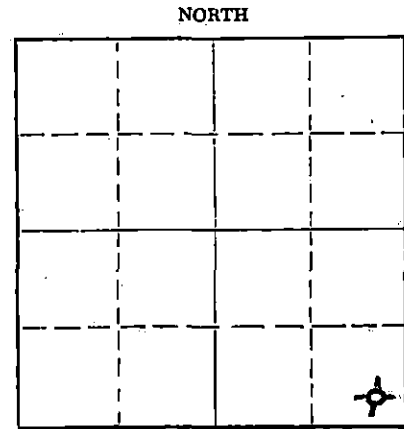

Locate well correctly on above Section Plot

Name of Conservation Agent who supervised plugging of this well Gilbert Toman

Producing formation Depth to top Bottom Total Depth of Well 3342 Feet

Show depth and thickness of all water, oil and gas formations.

OIL, GAS OR WATER RECORDS

CASING RECORD

FORMATION	CONTENT	FROM	TO	SIZE	PUT IN	PULLED OUT
				8 5/8" OD	215'	None

Describe in detail the manner in which the well was plugged, indicating where the mud fluid was placed and the method or methods used in introducing it into the hole. If cement or other plugs were used, state the character of same and depth placed, from feet to feet for each plug set.

Filled hole with heavy mud from 3342' TD to 200' pushed plug and 1/2 sack of hulls (rolled in sack and tied) to 200' and pumped in 20 sacks of cement thru drill pipe then filled with heavy mud to 40' and dumped in 1/2 sack of hulls and pushed plug down (held Kelly joint) and pumped in 10 sacks of cement filling hole to bottom of cellar.

Pumped 2 sacks of cement in rat hole.

RECEIVED  
STATE CORPORATION COMMISSION

SEP 29 1964

CONSERVATION DIVISION  
Wichita, Kansas

(If additional description is necessary, use BACK of this sheet)

Name of Plugging Contractor Red Tiger Drilling Co.

Address 1720 Wichita Plaza, Wichita, Kansas

STATE OF Kansas, COUNTY OF Barton, ss.  
J. W. Meyers

(employee of owner) or (owner or operator) of the above-described well, being first duly sworn on oath, says: That I have knowledge of the facts, statements, and matters herein contained and the log of the above-described well as filed and that the same are true and correct. So help me, God!

(Signature) J. W. Meyers

P.O. Box 308, Ellinwood, Kansas

(Address)

SUBSCRIBED AND SWORN TO before me this 25th day of September 1964

A. Kenneth Harris

My commission expires 5-22-66

Notary Public.



## CHAMPLIN OIL &amp; REFINING CO.

Richardson - Smith #1  
 SE SE SE of Sec. 6-20S-8W  
 Rice County, Kansas

Drillers Formation Log

0 <sup>+</sup> - 216 <sup>+</sup>	Surface Sand & Shale
216 <sup>+</sup> - 239 <sup>+</sup>	Red Bed
239 <sup>+</sup> - 241 <sup>+</sup>	Anhydrite
241 <sup>+</sup> - 245 <sup>+</sup>	Red Bed
245 <sup>+</sup> - 258 <sup>+</sup>	Anhydrite
258 <sup>+</sup> - 980 <sup>+</sup>	Shale & Shells
980 <sup>+</sup> - 1,065 <sup>+</sup>	Shale & Salt
1,065 <sup>+</sup> - 1,589 <sup>+</sup>	Lime & Shale
1,589 <sup>+</sup> - 2,045 <sup>+</sup>	Shale & Lime
2,045 <sup>+</sup> - 2,170 <sup>+</sup>	Shale & Shells
2,170 <sup>+</sup> - 2,434 <sup>+</sup>	Shale & Lime
2,434 <sup>+</sup> - 2,665 <sup>+</sup>	Lime & Shale
2,665 <sup>+</sup> - 2,720 <sup>+</sup>	Lime
2,720 <sup>+</sup> - 2,724 <sup>+</sup>	Shale
2,724 <sup>+</sup> - 2,729 <sup>+</sup>	Lime
2,729 <sup>+</sup> - 2,753 <sup>+</sup>	Lime & Shale
2,753 <sup>+</sup> - 3,105 <sup>+</sup>	Lime
3,105 <sup>+</sup> - 3,120 <sup>+</sup>	Cherty Lime
3,120 <sup>+</sup> - 3,184 <sup>+</sup>	Lime
3,184 <sup>+</sup> - 3,234 <sup>+</sup>	Shale & Lime
3,234 <sup>+</sup> - 3,342 <sup>+</sup>	Lime
3,342 <sup>+</sup>	TOTAL DEPTH

RECEIVED  
 STATE CORPORATION COMMISSION

SEP 29 1964

CONSERVATION DIVISION  
 Wichita, Kansas