


STATE OF KANSAS
STATE CORPORATION COMMISSION

Give All Information Completely
Make Required Affidavit
Mail or Deliver Report to:
Conservation Division
State Corporation Commission
212 No. Market
Wichita, Kansas

WELL PLUGGING RECORD

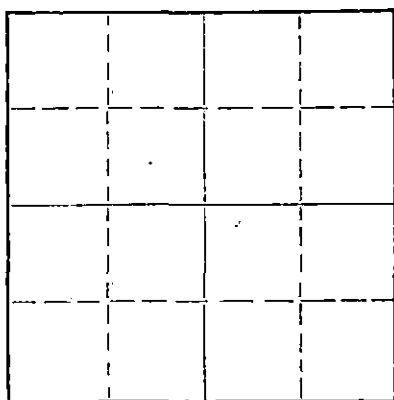

Locate well correctly on above
Section Plat

Rice County, Sec. 18 Twp. 20S Rge. 8W (E) (W)
Location as "NE/CNW/SW" or footage from lines E/2 NE SE
Lease Owner Ben C. W. Hyde, Jr. & ISERN-WELLS
Lease Name SWENSON Well No. 1
Office Address Box 8316, Prairie Village, Kansas 66208
Character of Well (completed as Oil, Gas or Dry Hole) Dry Hole
Date well completed January 31 ~~XXXXXX~~ 1970
Application for plugging filed Feb. 2 1970
Application for plugging approved January 31 1970
Plugging commenced January 31 1970
Plugging completed January 31 1970
Reason for abandonment of well or producing formation Dry Hole

If a producing well is abandoned, date of last production _____ 19____
Was permission obtained from the Conservation Division or its agents before plugging was commenced? yes

Name of Conservation Agent who supervised plugging of this well Gilbert Toman
Producing formation _____ Depth to top _____ Bottom _____ Total Depth of Well 3550 Feet
Show depth and thickness of all water, oil and gas formations.

OIL, GAS OR WATER RECORDS

CASING RECORD

FORMATION	CONTENT	FROM	TO	SIZE	PUT IN	PULLED OUT
Shale		115	215	8 5/8"	212	NONE

Describe in detail the manner in which the well was plugged, indicating where the mud fluid was placed and the method or methods used in introducing it into the hole. If cement or other plugs were used, state the character of same and depth placed, from _____ feet to _____ feet for each plug set.

Squeezed 2 wooden plugs and 1/2 sack hulls and 50 sacks Sun Quick
Set down casing to 45'. Let set 1 1/2 hours. Shoved 1 plug 1/2 sack
hulls and poured 19 sacks dry cement filled hole to bottom of cellar.
Two sacks in Rat Hole.

RECEIVED
STATE CORPORATION COMMISSION
FEB 5 1970
CONSERVATION DIVISION
Wichita, Kansas

(If additional description is necessary, use BACK of this sheet)
Name of Plugging Contractor ISERN DRILLING COMPANY
Address Box 486, Ellinwood, Kansas 67526

STATE OF KANSAS, COUNTY OF BARTON, ss.
W. F. Banks (employee of owner) or ~~(owner or operator)~~ of the above-described well, being first duly sworn on oath, says: That I have knowledge of the facts, statements, and matters herein contained and the log of the above-described well as filed and that the same are true and correct. So help me God.

(Signature) [Signature]
Box 486, Ellinwood, Kansas 67526
(Address)

SUBSCRIBED AND SWORN TO before me this 3rd day of February, 1970

My commission expires February 10, 1971
George A. Meyer Notary Public.

W E L L L O G

Ben C. W. Hyde, Jr. & ISERN-WELLS
 SWENSON #1, E/2 NE SE
 Section 18-20S-8W
 Rice County, Kansas

RECEIVED
 STATE CORPORATION COMMISSION
 FEB 5 1970
 CONSERVATION DIVISION
 Wichita, Kansas

ELEVATION: 1660' GL; 1662' DF; 1664' KB.

PIPE RECORD:

Figures indicate bottom of formation:

8 5/8" set at 212'	0	to	70	clay
with 225 sacks.			125	sand
Dry and Abandoned.			215	shale
			2700	shale & shells
ROTARY COMMENCED: 1-24-70			3550	lime & shale
ROTARY COMPLETED: 1-31-70			3550	Rotary Total Depth

ELECTRIC LOG TOPS

Anhydrite	234
Heebner	2733
Brown Lime	2868
Lansing	2906
Kinderhook Lime	3310
Kinderhook Sand	3349
Maquoketa	3423
Viola	3463
Simpson Sand	3517
Electric Log T.D.	3547
Rotary Total D.	3550


STATE OF KANSAS)
 COUNTY OF BARTON) ss

I, W. F. Banks, Drilling Superintendent of Isern Drilling Company, contractor for the above-described well, being first duly sworn on oath, declare: That I have knowledge of the facts, statements and matter herein contained pertaining to the log of the above described well, as filed, and that the same are true and correct.


 W. F. Banks

Subscribed and sworn to before me on this 3rd day of February, 1970.

My commission expires; 2-10-72

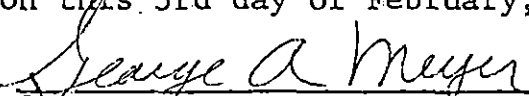
 George A. Meyer, Notary Public