


STATE OF KANSAS
STATE CORPORATION COMMISSION

Form CP-4

Give All Information Completely
Make Required Affidavit
Mail or Deliver Report to:
Conservation Division
State Corporation Commission

WELL PLUGGING RECORD

P. O. Box 17027
Wichita, Kansas 67217
NORTH

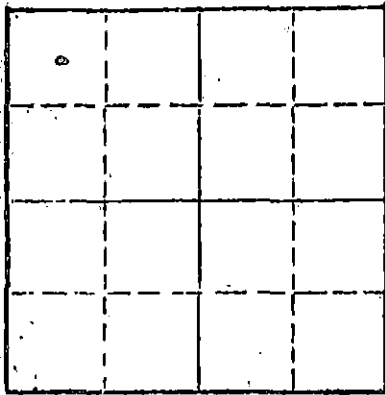

Locate well correctly on above
Section Plot

Rice County, Sec. 18 Twp. 20 Rge. (E) 8 (W) 8
Location as "NE/CNW/SW" or footage from lines C NW NW
Lease Owner Frank J. Black
Lease Name Speck Well No. 8
Office Address Box 150, McPherson, Kansas 67460
Character of Well (completed as Oil, Gas or Dry Hole) oil
Date well completed 19
Application for plugging filed 19
Application for plugging approved 19
Plugging commenced November 14 1973
Plugging completed May 15 1974
Reason for abandonment of well or producing formation depleted

If a producing well is abandoned, date of last production 19
Was permission obtained from the Conservation Division or its agents before plugging was commenced? yes

Name of Conservation Agent who supervised plugging of this well Hugh Scott
Producing formation _____ Depth to top _____ Bottom _____ Total Depth of Well 3460 Feet
Show depth and thickness of all water, oil and gas formations.

OIL, GAS OR WATER RECORDS

CASING RECORD

FORMATION	CONTENT	FROM	TO	SIZE	PUT IN	PULLED OUT
		0	212'	8 5/8"	212'	none
			3459'	4 1/2"	3459'	2363.56

Describe in detail the manner in which the well was plugged, indicating where the mud fluid was placed and the method or methods used in introducing it into the hole. If cement or other plugs were used, state the character of same and depth placed, from _____ feet to _____ feet for each plug set.

Sanded back to 3400' and dumped 4 sacks of cement.
Allied Cementing Company plugged well pumping in 3 sacks of bulls, 20 sacks of gel and 85 sacks of cement.

RECEIVED
STATE CORPORATION COMMISSION
MAY 23 1974
CONSERVATION DIVISION
Wichita, Kansas

(If additional description is necessary, use BACK of this sheet)
Name of Plugging Contractor PIPE PULLERS, INC.
Address Box 486, Ellinwood, Kansas 67526

STATE OF KANSAS COUNTY OF BARTON ss.
Evelyn Roth (employee of owner) or (owner or operator) of the above-described well, being first duly sworn on oath, says: That I have knowledge of the facts, statements, and matters herein contained and the log of the above-described well as filed and that the same are true and correct. So help me God.

(Signature) Evelyn Roth
Ellinwood, Kansas (Address)

SUBSCRIBED AND SWORN to before me this 21 day of May 1974

My commission expires Feb. 10, 1975

George A. Meyer
Notary Public

ORIGINAL

DEC 27 1969

15-159.20256.0000

COMPANY Champlin Petroleum Company

SEC. 18 T. 20S R. 8W
LOC. C NW NW

FARM Speck NO. 8

TOTAL DEPTH 3,460'
COMM. September 30, 1969 COMP. October 8, 1969

COUNTY Rice

SHOT OR TREATED
CONTRACTOR H-30, INC.
ISSUED

KANSAS		

CASING

20 10 5/8 212' cemented w/ 225 sx cement
 15 6
 12 5
 13 4-1/2" 3459' cemented w/175 sx cement

ELEVATION 1660 GR
1663 DF
1665 KB

PRODUCTION oil

FIGURES INDICATE BOTTOM OF FORMATIONS

Top Soil & Clay	110
Red Bed	250
Shale	1100
Lime & Shale	1670
Shale	2330
Shale & Lime	2375
Lime & Shale	2890
Lime	3025
Lime & Shale	3205
Shale & Lime w/ Chert	3268
Lime & Shale	3410
Sand & Shale	3460
Rotary Total Depth	3460

RECEIVED
STATE CORPORATION COMMISSION
AUG 13 1973
CONSERVATION DIVISION
Wichita, Kansas

I hereby certify the above and foregoing to be a true and correct log of the above described well as shown by the drilling reports.

Arlo B. Romer
Arlo B. Romer

NOTARY PUBLIC
STATE OF KANSAS
COUNTY OF SEDGWICK

SS:

PUBLIC Subscribed and Sworn to before me a Notary Public in and for said county and state this 21st day of October, 1969.

Richard G. Smith
Richard G. Smith - Notary Public

My Commission Expires: 10-8-72