

STATE OF KANSAS
STATE CORPORATION COMMISSION


Form CP-4

Give All Information Completely
Make Required Affidavit
Mail or Deliver Report to:
Conservation Division
State Corporation Commission

WELL PLUGGING RECORD

P. O. Box 17027
Wichita, Kansas 67217
NORTH

Rice County, Sec. 18 Twp. 20 Rge. (E) 8 (W)
Location as "NE/CNW/SW" or footage from lines SW NE SW
Lease Owner Frank J. Black
Lease Name Speck Well No. 7
Office Address Box 150, McPherson, Kansas 67460
Character of Well (completed as Oil, Gas or Dry Hole) Input
Date well completed 1973
Application for plugging filed 1973
Application for plugging approved 1973
Plugging commenced September 21 1973
Plugging completed May 15 1974
Reason for abandonment of well or producing formation no longer needed

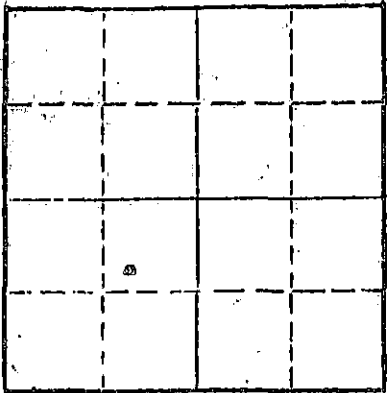

Locate well correctly on above
Section Plot

If a producing well is abandoned, date of last production 1973
Was permission obtained from the Conservation Division or its agents before plugging was commenced? yes

Name of Conservation Agent who supervised plugging of this well Hugh Scott
Producing formation _____ Depth to top _____ Bottom _____ Total Depth of Well 3660 Feet
Show depth and thickness of all water, oil and gas formations.

OIL, GAS OR WATER RECORDS CASING RECORD

FORMATION	CONTENT	FROM	TO	SIZE	PUT IN	PULLED OUT
		0	218'	8 5/8"	218'	none
			354 1/2'	4 1/2"	354 1/2'	2940.97

Describe in detail the manner in which the well was plugged, indicating where the mud fluid was placed and the method or methods used in introducing it into the hole. If cement or other plugs were used, state the character of same and depth placed, from _____ feet to _____ feet for each plug set.

Sanded back to 3500' and dumped 1/2 sacks of cement.
Allied Cementing Company plugged well pumping in 3 sacks of hulls, 20 sacks of gel and 85 sacks of cement.

RECEIVED
STATE CORPORATION COMMISSION
MAY 23 1974
CONSERVATION DIVISION
Wichita, Kansas

Name of Plugging Contractor PIPE PULLERS, INC.
Address Box 486, Ellinwood, Kansas 67526

STATE OF KANSAS COUNTY OF BARTON ss.
Evelyn Roth (employee of owner) or (owns or operates) of the above-described

well, being first duly sworn on oath, says: That I have knowledge of the facts, statements, and matters herein contained and the log of the above-described well as filed and that the same are true and correct. So help me God.

(Signature) Evelyn Roth
Ellinwood, Kansas (Address)

Subscribed and sworn to before me this 21 day of May 1974

My commission expires Feb. 10, 1975
Nancy A. Meyer Notary Public

COPY


WELL LOG BUREAU—KANSAS GEOLOGICAL SOCIETY
508 East Murdock, Wichita, Kansas

Company- CHAMPLIN PETROLEUM CO.
Farm- Speck No. 7

SEC. 18 T. 20 R. 8W
SW NE SW

Total Depth. 3660'
Comm. 11-2-64 Comp. 11-11-64
Shot or Treated.
Contractor. Red Tiger Drlg.
Issued. 2-27-65

County Rice KANSAS

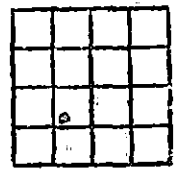

Elevation. 1663 DF

Production. 51 BOPD 82% W

Figures indicate Bottom of Formations.

sand	65
shale	228
anhydrite	239
shale & shells	700
shale & lime	2335
lime	3330
lime shale & sand	3393
lime & shale	3470
lime	3660
Total Depth	3660

TOPS: Scout	
Heebner	2725
Brown Lime	2867
Lansing	2902
Base Kansas City	3191
Kinderhook Lime	3283
Upper Sand	3298
Lower Sand	3314-33
Kinderhook Shale	3350
Maquoketa	3387
Log Total Depth	3393
Viola (Sample)	3431
Simpson Sand (SMP)	3490-98
Arbuckle (Sample)	3538

RECEIVED
STATE CORPORATION COMMISSION
AUG 13 1973
CONSERVATION DIVISION
Wichita, Kansas