


STATE OF KANSAS  
STATE CORPORATION COMMISSION

Form CP-4

Give All Information Completely  
Make Required Affidavit  
Mail or Deliver Report to:  
Conservation Division  
State Corporation Commission  
P. O. Box 17027  
Wichita, Kansas 67217  
NORTH

WELL PLUGGING RECORD

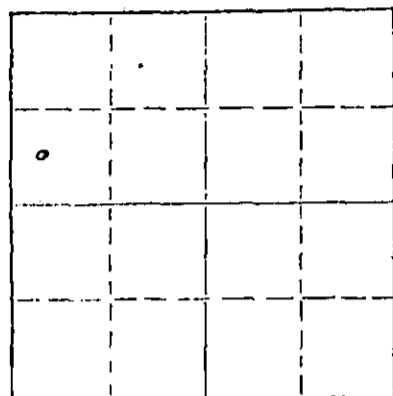

Locate well correctly on above  
Section Plat

Rice County. Sec. 18 Twp. 20 Rge. (E) 8 (W) 8  
Location as "NE/CNWSW" or footage from lines 145' W of C SW NW  
Lease Owner Frank J. Black  
Lease Name Speck Well No. 2  
Office Address Box 150, McPherson, Kansas 67460  
Character of Well (completed as Oil, Gas or Dry Hole) oil  
Date well completed \_\_\_\_\_ 19\_\_\_\_  
Application for plugging filed \_\_\_\_\_ 19\_\_\_\_  
Application for plugging approved \_\_\_\_\_ 19\_\_\_\_  
Plugging commenced February 18 19 74  
Plugging completed May 15 19 74  
Reason for abandonment of well or producing formation depleted  
If a producing well is abandoned, date of last production \_\_\_\_\_ 19\_\_\_\_  
Was permission obtained from the Conservation Division or its agents before plugging was commenced? yes

Name of Conservation Agent who supervised plugging of this well Hugh Scott  
Producing formation \_\_\_\_\_ Depth to top \_\_\_\_\_ Bottom \_\_\_\_\_ Total Depth of Well 3377 Feet  
Show depth and thickness of all water, oil and gas formations.

OIL, GAS OR WATER RECORDS

CASING RECORD

FORMATION	CONTENT	FROM	TO	SIZE	PUT IN	PULLED OUT
		0	213'	8 5/8"	213'	none
			3365'	4 1/2"	3365'	2896.78

Describe in detail the manner in which the well was plugged, indicating where the mud fluid was placed and the method or methods used in introducing it into the hole. If cement or other plugs were used, state the character of same and depth placed, from \_\_\_\_\_ feet to \_\_\_\_\_ feet for each plug set.

Sanded back to 3340' and dumped 4 sacks of cement.

Allied Cementing Company plugged well pumping in 3 sacks of hulls, 20 sacks of gel and 85 sacks of cement.

RECEIVED  
STATE CORPORATION COMMISSION  
MAY 23 1974  
CONSERVATION DIVISION  
Wichita, Kansas

(If additional description is necessary, use BACK of this sheet)  
Name of Plugging Contractor PIPE PULLERS, INC.  
Address Box 486, Ellinwood, Kansas 67526

STATE OF KANSAS, COUNTY OF BARTON, SS.  
Evelyn Roth (employee of owner) or (owner or operator) of the above-described

well, being first duly sworn on oath, says: That I have knowledge of the facts, statements, and matters herein contained and the log of the above-described well as filed and that the same are true and correct. So help me God.

(Signature) Evelyn Roth  
Ellinwood, Kansas (Address)

SUBSCRIBED AND SWORN TO before me this 21 day of May 19 74

My commission expires Feb. 10, 1975

Seay H. Meyer  
Notary Public

COPY


WELL LOG BUREAU—KANSAS GEOLOGICAL SOCIETY  
508 East Murdock, Wichita, Kansas

Company- CHAMPLIN OIL & REFINING CO.  
Farm- J.M. Speck No. 2

SEC. 18 T. 20 R. 8W  
14.5' W OF C SW NW

Total Depth: 3377'  
Comm. 6-17-64 Comp. 6-23-64  
Shot or Treated.  
Contractor. Red Tiger Drilling Co.  
Issued. 10-24-64

County Rice KANSAS

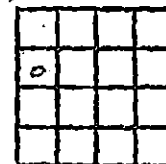

Elevation. 1662' DF

Production. 82 BOPD, NW

CASING:

8 5/8" 213' cem w/175 sx.  
4 1/2" 3365' cem w/75 sx.

Figures Indicate Bottom of Formations.

surface soil & clay	15
sand	55
shale	85
gravel & sand	98
shale & redbed	214
redbed	221
Anhydrite	240
redbed & shale	460
shale & shells	1038
shale & lime w/shells	1075
lime	1340
lime & shale	1560
shale, lime & shells	2230
lime & shale	2335
lime	2730
lime & shale	2817
shale	2858
lime	2872
shale	2887
lime	3220
lime & shale	3290
shale	3377 RTD
Total Depth	

TOPS: LOG

Heebner	2723
Brown Lime	2859
Lansing	2892
Base Kansas City	3180
Kinderhook Lime	3254
Kinderhook Sand	3263
Kinderhook Sand	3271
Maquoketa	3348

RECEIVED  
STATE CORPORATION COMMISSION

AUG 13 1973

CONSERVATION DIVISION  
Wichita, Kansas