


STATE OF KANSAS
STATE CORPORATION COMMISSION

Form CP-4

Give All Information Completely
Make Required Affidavit
Mail or Deliver Report to:
Conservation Division
State Corporation Commission
211 No. Broadway
Wichita, Kansas

WELL PLUGGING RECORD

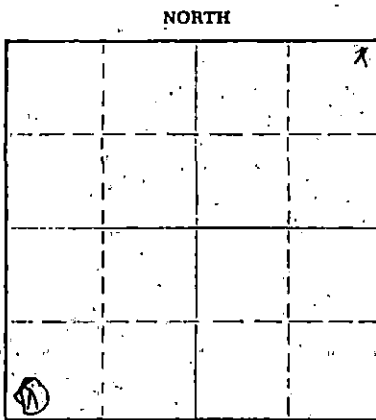

Locate well correctly on above
Section Plot

Location as "NE/CNW/SW" or footage from lines Rice County, Sec 24 Twp. 20 Rge. 10 (E) (X)
Lease Owner Mrs. Thompson Inc
Lease Name Proffitt C Well No. 1
Office Address 217 - East 8th Topeka Kansas
Character of Well (completed as Oil, Gas or Dry Hole) Oil
Date well completed 6-19 1965
Application for plugging filed 6-19 1965
Application for plugging approved Gilbert Toman 1965
Plugging commenced 6-19 1965
Plugging completed 6-19 1965
Reason for abandonment of well or producing formation Depleted

If a producing well is abandoned, date of last production 19
Was permission obtained from the Conservation Division or its agents before plugging was commenced? Yes

Name of Conservation Agent who supervised plugging of this well Gilbert Toman
Producing formation Tarkio Depth to top 2300 Bottom 2930 Total Depth of Well 2460 Feet
Show depth and thickness of all water, oil and gas formations:

OIL, GAS OR WATER RECORDS

CASING RECORD

FORMATION	CONTENT	FROM	TO	SIZE	PUT IN	PULLED OUT

Describe in detail the manner in which the well was plugged, indicating where the mud fluid was placed and the method or methods used in introducing it into the hole. If cement or other plugs were used, state the character of same and depth placed, from 2460 feet to

Sand from 2460 to 2330 3 sacks Cement 2330 to 2300
Rock Plug from 190 to 180 20 sacks Cement 180 to 120
Mud 120 to 3577 10 Cement 3577 to Bottom of Celler

RECEIVED
STATE CORPORATION COMMISSION

7-26-65 JUL 26 1965

CONSERVATION DIVISION
Wichita, Kansas

(If additional description is necessary, use BACK of this sheet)
Name of Plugging Contractor James W. Thompson
Address Box 106 Ellingwood Kansas

STATE OF Kansas COUNTY OF Shawnee ss.
James W. Thompson (employee of owner) or (owner or operator) of the above-described well, being first duly sworn on oath, says: That I have knowledge of the facts, statements, and matters herein contained and the log of the above-described well as filed and that the same are true and correct. So help me God.

(Signature)

James W. Thompson
217 E. 8th Topeka, Kans.
(Address)

SUBSCRIBED AND SWORN TO before me this 23rd day of July, 1965

My commission expires Sept 10, 1968

Camilla Maichel
Notary Public.

DRILLER'S LOG
MUIR-THOMPSON, INC.
#1 PROFFITT "C"
NW NW NW, SEC. 24-20S-10W
RICE COUNTY, KANSAS

Contractor - M-S-T Drilling Company, Inc.

```
Commenced: 10/15/63
Completed: 10/24/63
Elevation: 1811 KB
Equipment
  Installed: 10/31/63
Abandoned: 12/30/63 as D & A
```

<u>From</u>	<u>To</u>	<u>Remarks</u>	<u>Description</u>
0	80	Surface soil	190' 8 5/8" with 135 sacks
80	170	Shale & shells	cement
170	190	Surface sand & shale	
190	500	Red Bed	2549' 4 1/2" sacks
500	1090	Shale & shells	
1090	1110	Shale & shells	
1110	1205	Salt & shale	
1205	1290	Shale & lime	
1290	1400	Lime & shale	
1400	1700	Broken lime	
1700	1840	Lime & shale	
1840	2020	Lime & shale	
2020	2175	Lime & shale	
2175	2315	Shale & lime	
2315	2335	Sand & shale	
2335	2340	Shale & lime	
2340	2342	Shale	
2342	2550	Shale & shells	
2550	2640	Shale & lime	
2640	2714	Lime	
2714	2774	Lime	
2774	2880	Lime	
2880	2967	Lime	
2967	3047	Lime	
3047	3095	Lime	
3095	3160	Lime	
3160	3213	Lime	
3213	3265	Lime	
3265	3307	Lime	
3307	3340	Lime	
3340	3360	Lime	
3360	3370	Lime	
3370	3390	Lime	
3390		Rotary Total Depth	


RECEIVED
 STATE CORPORATION COMMISSION
 OCT 29 1965
 CONSERVATION DIVISION
 Wichita, Kansas

RECEIVED
STATE CORPORATION COMMISSION

OCT 29 1965

CONSERVATION DIVISION
Wichita, Kansas

I certify to the best of my knowledge and belief, the above represents a true and accurate Driller's Log record of the captioned well.


James W. Thompson

State of Kansas)
) SS:
County of Shawnee)

Subscribed and sworn to before me this 26th day of January, 1965.

My Commission Expires Sept. 21, 1968

Ann P. Atkins
Ann P. Atkins, Notary Public