


STATE OF KANSAS
STATE CORPORATION COMMISSION

WELL PLUGGING RECORD
OR
FORMATION PLUGGING RECORD

Strike out upper line when reporting plugging of formations.

Give All Information Completely
Make Required Affidavit
Mail or Deliver Report to:
Conservation Division
State Corporation Commission
800 Bluing Building
Wichita, Kansas

NORTH

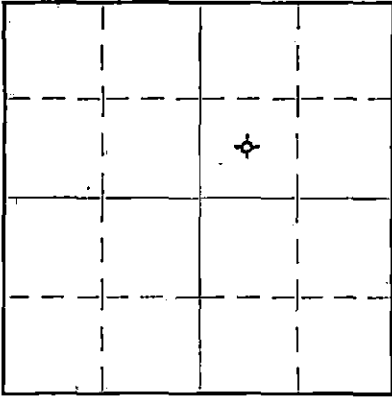

Locate well correctly on above Section Plat

Rice County. Sec. 24 Twp. 20S Rge. 10 XEY (W)
Location as "NE 1/4 NW 1/4 SW 1/4" or footage from lines SW 1/4 NE 1/4
Lease Owner The W-K Royalty Company
Lease Name Loring Well No. 1
Office Address 335 West Lewis Street, Wichita, Kansas
Character of Well (Completed as Oil, Gas or Dry Hole) Dry Hole
Date, well completed March 24, 1937
Application for plugging filed March 25, 1937
Application for plugging approved March 25, 1937
Plugging Commenced March 25, 1937
Plugging Completed March 26, 1937
Reason for abandonment of well or producing formation Dry

If a producing well is abandoned, date of last production 193
Was permission obtained from the Conservation Division or its agents before plugging was commenced? Yes

Name of Conservation Agent who supervised plugging of this well C. T. Alexander
Producing formation Siliceous Depth to top 3390 Bottom 3440 Total Depth of Well 3440 Feet.
Show depth and thickness of all water, oil and gas formations.

OIL, GAS OR WATER RECORDS

CASING RECORD

Formation	Content	From	To	Size	Put In	Pulled Out
K. C. Lime	Dry	3033	3156	7"	None - Cored	

Describe in detail the manner in which the well was plugged, indicating where the mud fluid was placed and the method or methods used in introducing it into the hole. If cement or other plugs were used, state the character of same and depth placed, from _____ feet to _____ feet for each plug set.

Hole filled with heavy rotary mud from 3440 feet to 160 feet; hole bridged at 160 feet and a 15-foot cement plug set on bridge and a cement plug set in the top of the surface pipe at bottom of cellar.

PLUGGING
FILE OCT 24 20 1937
BOOK PA: 82 6

(If additional description is necessary, use BACK of this sheet)

Correspondence regarding this well should be addressed to The W-K Royalty Company
Address 335 West Lewis, Wichita, Kansas

STATE OF KANSAS, COUNTY OF SEDGWICK, ss.
C. C. Chapin (employee of owner) or (owner or operator) of the above-described well,
being first duly sworn on oath, says: That I have knowledge of the facts, statements, and matters herein contained and the log of the above-described well as filed and that the same are true and correct. So help me God.

(Signature) C C Chapin

335 West Lewis Street, Wichita, Kansas
(Address)

SUBSCRIBED AND SWORN to before me this 26th day of October, 1937

My commission expires September 12, 1938

Mary E. Clark

Notary Public.

WELL LOG AND DRILLING REPORT
 THE W-K ROYALTY COMPANY
 335 West Lewis St.
 Wichita, Kans.

15.159.04526.0000

March 26, 1937

The W-K Royalty Company
 Leming No. 1

SW SW NE 24-20-10
 Rice County, Kansas
 Elevation 1804'

Date	Depth	Formation	Remarks
1937			
3-6			Rig Up
3-7	0-65	Surface Clay	
	65-85	Clay and Sand	
	85-160	Shale	
3-8			Run 155' 12 1/2" Casing
3-9			Waiting on Casing
3-10	139-160	Plug & Cement	
	160-220	Red Rock	Drilled Plug
	220-425	Red Bed	
3-11	425-453	Red Bed	
	453-630	Red & Blue Shale	Slope Test at 500 O.K.
	630-875	Shale Red Rock	
	875-980	Shale & Shells	
	980-1110	Salt	Slope Test at 1000 O.K.
	1110-1127	Shale	
3-12	1127-1176	Salt	
	1176-1257	Shale & Lime Shells	
	1257-1375	Broken Lime Gyp	Run Slope Test 1250 O.K.
3-13	1375-1481	Lime Broken	
3-13	1481-1596	Broken Lime	
	1596-1696	Broken Lime	Slope Test at 1500 O.K.
	1696-1770	Broken Lime	
3-14	1770-1866	Broken Lime	
	1866-1943	Lime	
	1943-2033	Lime Broken	1/2 trip on bottom 5:00
3-15	2033-2127	Broken Lime	Slope Test at 2000 O.K.
	2127-2233	Shale	
	2233-2300	Shale	
	2300-2338	Lime Shells & Shale	Slope Test at 2250 O.K.
3-16	2338-2422	Shale & Shells	Trip
	2422-2460	Shale	
	2460-2529	Broken Lime	
	2529-2585	Broken Lime	Slope Test at 2500 O.K.
	2585-2610	Lime	1/2 Trip
3-17	2610-2663	Lime	1/2 Trip
	2663-2715	Lime	(at 10 P.M.)
	2715-2768	Lime	Pulled Bit #6 at 2748 on bottom
3-18	2768-2780	Lime	
	2780-2800	Shale Sandy	
	2800-2843	Lime	Mixing mud
	2843-2888	Hard Lime & Chat	Run steal line for correct ion O.K.
	2888-2903	Lime	Cleaned shale out of pit
	2903-2925	Lime Broken	#8 Bit on bottom at 2913
3-19	2925-3008	Shale Broken	Circulated 30 min. at 3035
	3008-3033	Shale	Circulated 30 min. at 3060
	3033-3060	K. C. Lime	30 min. working on pump mot.
	3060-3100	K. C. Lime	
3-20	3100-3156	K. C. Lime	Trip
	3156-3206	Lime	Slope Test at 3065 O.K.
	3206-3240	Lime	Circulated 1:00 hr. at 3206
3-21	3240-3270	Broken Lime	1/2 Trip - Working on Motor
	3270-3321	Broken Lime	Went in hole - Steal tape M 2' cor.
	3321-3358	Lime Broken	
3-22	3358-3374	Sand & Broken Shale	
	3374-3388	Lime & Shale	
	3388-3390	S. Lime	
	3390-3395	Shale & S. Lime	Started out of hole to core at
3-23	3395-3403	Cored Lime	1:40 P.M.
	3403-3440	Lime & Shale	Reamed to 9" 24 20 10W
	3440-	Total Depth	82 6
3-24	3440		Circulating - waiting on orders
3-25			Plugged & Abandoned

STATE OF KANSAS)
 COUNTY OF SEDGWICK) SS

I, the undersigned, being duly sworn on oath, state that the above and within statement is a true and correct record and log of the well drilled on the location above described, to the best of my knowledge and belief.

Subscribed and sworn to before me this 26th day of March, 1937.

C. C. Chapin

My Commission Expires Sept. 12, 1938

Mary E. Clark
 Notary Public