


WELL PLUGGING RECORD

Give All Information Completely
Make Required Affidavit
Mail or Deliver Report to:
Conservation Division
State Corporation Commission
211 No. Broadway,
Wichita, Kansas

Rice County. Sec. 28 Twp. 20S Rge. 10W (E) (W)

Location as "NE/CNW&SW¼" or footage from lines NE NW NE
Lease Owner Petroleum Management, Inc.
Lease Name Bryant Well No. 1
Office Address 1019 Central Building, Wichita, Kansas
Character of Well (completed as Oil, Gas or Dry Hole) Dry Hole
Date well completed November 27, 1962 19
Application for plugging filed November 27, 1962 19
Application for plugging approved November 27, 1962 19
Plugging commenced November 27, 1962 19
Plugging completed November 27, 1962 19
Reason for abandonment of well or producing formation
dry hole

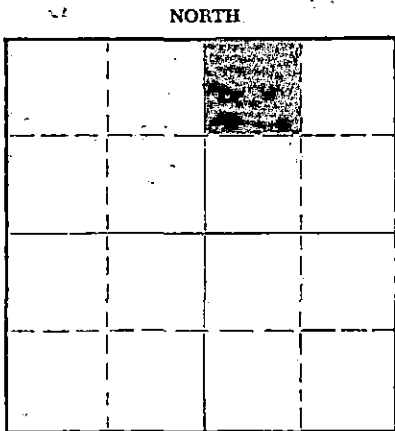

Locate well correctly on above Section Plat.

If a producing well is abandoned, date of last production _____ 19____
Was permission obtained from the Conservation Division or its agents before plugging was commenced? yes

Name of Conservation Agent who supervised plugging of this well Mr. Gilbert J. Toman, Holyrood, Kansas
Producing formation _____ Depth to top _____ Bottom _____ Total Depth of Well 3329 Feet
Show depth and thickness of all water, oil and gas formations.

OIL, GAS OR WATER RECORDS

CASING RECORD

FORMATION	CONTENT	FROM	TO	SIZE	PUT IN	PULLED OUT

Describe in detail the manner in which the well was plugged, indicating where the mud fluid was placed and the method or methods used in introducing it into the hole. If cement or other plugs were used, state the character of same and depth placed, from _____ feet to _____ feet for each plug set.

Filled with heavy mud to 180' and set #1 plug at 180' with 1/2 sack hulls and 20 sacks cement. Filled hole with heavy mud. Set #2 plug at 30' with 1/2 sack hulls, 8 sacks cement. Plugged rat hole with 2 sacks cement.

(If additional description is necessary, use BACK of this sheet)

Name of Plugging Contractor Gabbert-Jones Drilling Company
Address 514 Orpheum Building, Wichita, Kansas

STATE OF KANSAS, COUNTY OF SEDGWICK, ss.
Dale Silcott (employee of owner) or (owner or operator) of the above-described well, being first duly sworn on oath, says: That I have knowledge of the facts, statements, and matters herein contained and the log of the above-described well as filed and that the same are true and correct. So help me God.

(Signature) Dale Silcott
1019 Central Building, Wichita, Kansas
(Address)

SUBSCRIBED AND SWORN TO before me this 22 day of January, 1963

My commission expires April 23, 1966

Marie C. Murphy
Marie C. Murphy Notary Public.



GABBERT-JONES, INC.
 WICHITA, KANSAS
 DRILLERS WELL LOG

15.159.02894.0000

BRYANT #1
 150' East of NE NW NE Section 28-20S-10W
 Rice County, Kansas

Commenced: November 16, 1962
 Completed: November 27, 1962

OPERATOR: Petroleum Associates Fund, Inc.

DEPTH		FORMATION	REMARKS
From	To		
0	175	Sand & Soil	Ran 212' of 8-5/8" casing, W/185 Sacks HA-5 Cement
175	212	Red Bed & Shale	
212	415	Red Bed	
415	435	Anhydrite	
435	520	Red Bed & Shale	
520	1240	Red Bed & Shale	
1240	1280	Shale & Lime	
1280	1475	Shale & Lime	
1475	1695	Lime & Shale	
1695	1855	Lime & Shale	
1855	2000	Lime & Shale	
2000	2225	Shale & Lime	
2225	2415	Shale & Lime	
2415	2534	Shale & Lime	
2534	2555	Shale & Sand	
2555	2630	Lime	
2630	2750	Lime	
2750	2835	Lime	
2835	2985	Lime	
2985	3047	Lime	
3047	3080	Lime	
3080	3145	Lime	
3145	3224	Lime	
3224	3277	Lime	
3277	3297	Lime & Shale	
3297	3323	Lime & Shale	
3323	3329	Lime & Shale	
3329	TD		Dry & Abandoned

RECEIVED
 STATE CORPORATION COMMISSION

JAN 24 1963

CONSERVATION DIV
 WICHITA, KANSAS

I, E. E. HALL, certify this is a true and correct copy of the Driller's Log for the well drilled 150' East of NE NW NE Section 28-20S-10W, Rice County, Kansas, to the best of my knowledge and belief.

E. E. Hall

STATE OF KANSAS)
) SS
 COUNTY OF SEDGWICK)

Before me, the undersigned, a Notary Public within and for said County and State, on this 30th day of November, 1962, personally appeared E. E. HALL to me personally known to be the identical person who executed the within and foregoing instrument and acknowledged to me that he executed the same as his free and voluntary act and deed for the uses and purposes therein set forth.

IN WITNESS WHEREOF, I have hereunto set my hand and official seal the day and year last above written.

My Commission expires October 2, 1963

Vera A. McKenzie
 Vera A. McKenzie, Notary Public