

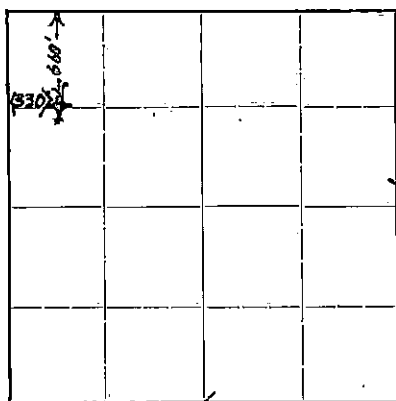
STATE OF KANSAS
CORPORATION COMMISSION

Give All Information Completely
Make Required Affidavit
Mail or Deliver Report to:
Conservation Division
State Corporation Commission
800 Bitting Building
Wichita, Kansas

WELL PLUGGING RECORD

OR

FORMATION PLUGGING RECORD

Strike out upper line
when reporting plug-
ging off formations.Locate well correctly on above
Section Plat

Rice County, Sec. 33 Twp. 20 Rge. 10 X (W)

Location as "NE $\frac{1}{4}$ NW $\frac{1}{4}$ SW $\frac{1}{4}$ " or footage from lines N.W. of the N.E. $\frac{1}{4}$

Lease Owner Luther Mackall

Lease Name Nellie Beaman Well No. 1

Office Address Union Nat'l. Bank Bld'g. Wichita, Kans.

Character of Well (completed as Oil, Gas or Dry Hole) Dry

Date well completed 1 - 11 - 19 42

Application for plugging filed 1 - 12 - 19 42

Application for plugging approved 19

Plugging commenced 1 - 28 - 19 42

Plugging completed 2 - 1 - 19 42

Reason for abandonment of well or producing formation Formation tested
proved to be non-productive

If a producing well is abandoned, date of last production Non-producer 19

Was permission obtained from the Conservation Division or its agents before plugging was com-
menced? Yes

Name of Conservation Agent who supervised plugging of this well Ruel Durkee

Producing formation None Depth to top. XXXX Bottom. XXXX Total Depth of Well 3345 Feet

Show depth and thickness of all water, oil and gas formations.

OIL, GAS OR WATER RECORDS

CASING RECORD

Formation	Content	From	To	Size	Put In	Pulled Out
Arbuckle	Dry	3327	3345	5 $\frac{1}{2}$ " O.D.	3133'6"	2426'1"
Iansing	1 Bbl. oil & 1 $\frac{1}{2}$ " Water per hr.	3061	3073			
		10 $\frac{3}{4}$ " - Surface Casing	260'			None
		(Cemented with 150 Sacks Cement)				

Describe in detail the manner in which the well was plugged, indicating where the mud fluid was placed and the method or methods used in introducing it into the hole. If cement or other plugs were used, state the character of same and depth placed, from _____ feet to _____ feet for each plug set.

Well was drilled to a total depth of 3345' in the Arbuckle lime which proved to run low and non-productive. Top of the Iansing was 2983'. A saturated zone was encountered from 3061' to 3071'. 5 $\frac{1}{2}$ " casing was set and cemented with 125 sacks of cement with the bottom of the casing setting at 3108', leaving the shoe joint (33'6") full of cement. This was not drilled out. Casing was perforated with 48 shots from 3061 to 3073, encountering a very light show of oil. Casing was also ripped from 3061 to 3071 with two separate slots this length. Well was acidized with a total of 7500 gallons of acid. After 48 hours of swabbing, bailing and testing well finished up making 1/4 barrel of oil and 1-1/2 barrels of water.

Mud put through 5-1/2" casing from 3073 to 3055. Put permanent bridge with 5 sacks of cement from 3055 back up to 3025'. Hole filled with heavy mud from 3055 to 150'. Made bridge with solid rock st 150'. Cemented with 10 sacks of cement from 150 to 130'. Hole was then filled with heavy mud from 130 to 15'. Remaining of surface pipe was filled with cement to cellar base. All of the above cementing was placed with a dump-bailer and sand line. All of the above mudding was did by elevating rotary mud with a steel barrel from the drilling pits.

FILE 35-33-20-100

BOOK PAGE 22, E-1

(If additional description is necessary, use BACK of this sheet)

Correspondence regarding this well should be addressed to Luther Mackall, c/o Gilbert Moore.

Address Union National Bank Building Wichita, Kansas.

STATE OF _____, COUNTY OF _____

_____ (employee of owner) or (owner or operator) of the above-described well,
being first duly sworn on oath, says: That I have knowledge of the facts, statements, and matters herein contained and the log of the above-described well as filed and that the same are true and correct. So help me God.

(Signature)

Luther E. Mackall
by Gilbert Moore, Atty in fact,
517 Union Nat'l Bank Bldg
Wichita, Kans.

SUBSCRIBED AND SWORN to before me this 9th day of February, 19 42

My commission expires Feb 2-1944

Notary Public.

Well: Luther Mackall Beamman # 1
Location: C/Wy NE, NE 33-208-108
County: Rice
Contractor: Rocket Drilling Company

Total Depth: 3345
Commenced: 12-9-41
Completed: 1-10-42
Initial Pot.: D & A

15.159.03168.0000

Sand & gravel	0 - 40
Sand	40 - 70
Shale blue	70 - 130
Red rock & shells	130 - 261
Red rock	261 - 390
Shells & shale	390 - 415
Shale	415 - 443
Shale & anhydrite	443 - 785
Salt & shale	785 - 840
Shale & anhydrite	840 - 900
Shale blue	900 - 1080
Salt, shale & lime shells	1080 - 1208
Lime broken	1208 - 1295
Lime	1295 - 1372
Broken lime & shale	1372 - 1494
Broken lime	1494 - 1513
Lime	1513 - 1689
Shale	1689 - 1720
Broken lime	1720 - 1747
Shale	1747 - 1770
Lime	1770 - 1962
Broken lime & shale	1962 - 2095
Broken lime	2095 - 2137
Broken lime & shale	2137 - 2285
Lime	2285 - 2317
Broken lime & shale	2317 - 2335
Lime	2335 - 2366
Shale	2366 - 2393
Broken lime & shale	2393 - 2528
Soft chalky lime	2528 - 2543
Lime	2543 - 2913
Shale	2913 - 2959
Lime	2959 - 3062
Lime soft	3062 - 3072
Lime	3072 - 3166
Lime soft	3166 - 3175
Lime	3175 - 3239
Lime Broken & soft	3239 - 3250
Lime	3250 - 3292
Sand broken	3292 - 3304
Shale	3304 - 3322
Sand	3322 - 3327
Dolomite (Arbuckle)	3327 - 3345 T.D.

33-20-10W
22

STATE OF KANSAS)
) SS
COUNTY OF SEDGWICK)

I, the undersigned, being duly sworn on oath, state that the above and within statement is a true and correct record and log of the well drilled on the location above described, to the best of my knowledge and belief.

Subscribed and sworn to before me this 15th day of January, 1942.

Loren A. Whalen
Notary Public

My commission expires: Sept 1, 1943

