


STATE OF KANSAS
STATE CORPORATION COMMISSION
200 Colorado Derby Bldg.
Wichita, Kansas 67202

Form CP-4
Rev. 12-15-80

WELL PLUGGING RECORD

Give All Information Completely
Make Required Affidavit

COUNTY Rice SEC. 26 TWP. 20S RGE. 10W E/W
Location as in quarters or footage from lines:
330 FWL, 1650 FSL

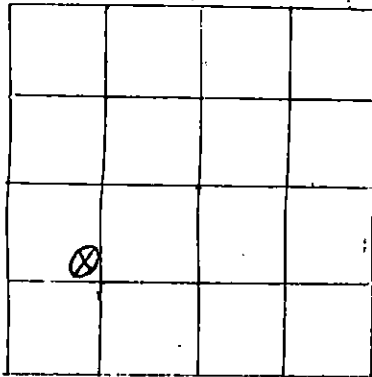

Locate Well
correctly on above
Section Platt.

Lease Owner Clarion Resources Inc.
Lease Name Loesch Well No. 1-26
Office Address 1625 Broadway, Suite 1800, Denver, Colo 80202
Character of Well (Completed as Oil, Gas or Dry Hole): Dry Hole
Date Well Completed 5-18-81
Application for plugging filed 5-18-81 Verbal
Plugging commenced 5-19-81
Plugging completed 06:00 AM 5-19-81
Reason for abandonment of well or producing formation
No Commercial Products encountered
Was permission obtained from the Conservation Division or it's
Agent's before plugging was commenced? Yes

Name of Conservation Agent who supervised plugging of this well Gilbert J Toman
Producing formation None Depth to top bottom T.D. 3463
Show depth and thickness of all water, oil and gas formations.

OIL, GAS OR WATER RECORDS

Casing Record

Formation	Content	From	To	Size	Put in	Pulled Out

Describe in detail the manner in which the well was plugged, indicating where the mud fluid was placed and the method or methods used in introducing it into the hold. If cement or other plugs were used, state the character of same and depth placed, from feet to feet for each plug set.

Fill Hole with Heavy Mud
Set first plug at 375' with 50 Sks
Set second plug at 40' to surface with 10 Sks
Plug down at 06:00 AM 5-19-81

(If additional description is necessary, use BACK of this sheet)

Name of Plugging Contractor Banner Drilling Co.

STATE OF Kansas COUNTY OF Ellis, ss.

K.D. Caldwell (employee of owner) or (owner or operator) of the
above-described well, being first duly sworn on oath, says: That I have knowledge of the
facts, statements, and matters herein contained and the log of the above-described well as
filed and that the same are true and correct. So help me God.

(Signature) K.D. Caldwell

312 Skyline Court, Hays, Ks 67601
(Address)

SUBSCRIBED AND SWORN TO before me this 31st day of Aug, 19 81

Betty Crews

Notary Public.

My Commission expires: Aug 16, 1984

RECEIVED
STATE CORPORATION COMMISSION

SEP - 3 1981

CONSERVATION DIVISION
Wichita, Kansas



WELL LOG

15.159.21158.0000

OPERATOR: Clarion Resources Inc.
 CONTRACTOR: Banner Drilling Co.
 WELL NAME: Loesch 1-26
 LOCATION: 330 FWL, 1650 FSL, Section 26-20S-10W
 Rice County, Kansas
 SPUD DATE: 5-7-81
 COMPLETION DATE: 5-18-81

0	231	Sand
231	1400	Shale & Lime
1400	2042	Lime & Shale
2042	2108	Sand & Shale
2108	2230	Shale
2230	2300	Sand & Shale
2300	3300	Lime & Shale
3300	3336	Sand & Shale
3336	3460	Dolomite
3463		Rotary total depth

Spud at 7:00 PM 5-7-81. Drill 231' of 11" hole. Run 222' of 8 5/8" 24# surface pipe. Weld all collars. Set surface at 228' KB. Cement with 200 Sks common with 2% Gel and 3% CaCl with Sun Cementers. Plug down at 12:45 AM 5-8-81. Cement did circulate.

TD at 3463'. Plug with 60 Sks 50-50 Poz with 4% Gel and 3% CaCl. First plug at 375' with 50 Sks, Second plug at 40' to surface with 10 Sks. Job complete at 6:00 AM 5-19-81. Banner rig #4 does not require a Rat hole.

SAMPLE TOPS:	Winfield	1411'	(+ 399')	Lansing	3004'	(-1254')
	Tarkio	2230'	(- 480')	B/Ks Conglomerate	3288'	(-1538')
	Heebner	2844'	(-1094')	Viola	3307'	(-1557')
	Toronto	2865'	(-1115')	Simpson	3318'	(-1568')
	Brown Lime	2984'	(-1234')	Arbuckle	3362'	(-1612')

STATE OF KANSAS }
 COUNTY OF ELLIS } SS

K.D.Caldwell, Drilling consultant for Clarion Resources Inc., does hereby state that the above and foregoing is a true and correct copy of the log of the Loesch #1-26 Section 26-20S-10W, 330 FWL, 1650 FSL, Rice County Kansas.

CLARION RESOURCES INC.

BY: K.D. Caldwell
 K.D. Caldwell, Drilling Consultant

Subscribed and sworn to before me, a Notary Public, in and for the aforesaid county and the state as of this 31 day of August, 1981.



Betty Crews
 Notary Public

RECEIVED
 STATE CORPORATION COMMISSION

SEP - 3 1981

CONSERVATION DIVISION
 Wichita, Kansas