


WELL PLUGGING RECORD

Give All Information Completely
Make Required Affidavit
Mail or Deliver Report to:
Conservation Division
State Corporation Commission
800 Bitting Building
Wichita, Kansas

_____ RICE _____ County. Sec. 35 Twp. 20S Rge. 10 (E) W (W)
Location as "NE/CNW/SW" or footage from lines. SE SE NW
Lease Owner Shelley-Miller Drilling, Inc.
Lease Name Burns Well No. 1
Office Address 205 Miller Bldg., Wichita, Kansas
Character of Well (completed as Oil, Gas or Dry Hole) Dry Hole
Date well completed June 2 19 55
Application for plugging filed June 2 19 55
Application for plugging approved June 2 19 55
Plugging commenced June 2 19 55
Plugging completed June 2 19 55
Reason for abandonment of well or producing formation Failure to produce
in commercial quantities

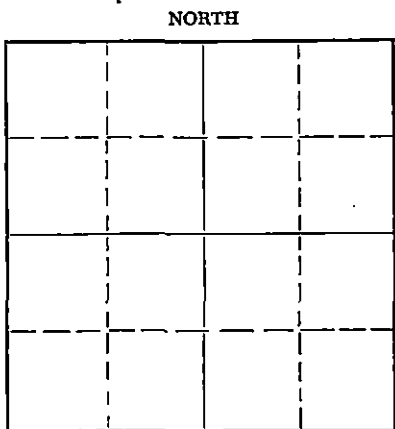

Locate well correctly on above
Section Flat

If a producing well is abandoned, date of last production _____ 19 _____
Was permission obtained from the Conservation Division or its agents before plugging was commenced? Yes

Name of Conservation Agent who supervised plugging of this well Earl Durkee
Producing formation _____ Depth to top _____ Bottom _____ Total Depth of Well 3374 Feet
Show depth and thickness of all water, oil and gas formations.

OIL, GAS OR WATER RECORDS

CASING RECORD

FORMATION	CONTENT	FROM	TO	SIZE	PUT IN	PULLED OUT
				8 5/8	190'	

Describe in detail the manner in which the well was plugged, indicating where the mud fluid was placed and the method or methods used in introducing it into the hole. If cement or other plugs were used, state the character of same and depth placed, from _____ feet to _____ feet for each plug set.

Bottom Plug set @ 185' 15 sacks cement
Top Plug set @ 35' 10 sacks cement

RECEIVED
JUN 7 1955
CONSERVATION DIVISION
WICHITA, KANSAS
6-8-55

(If additional description is necessary, use BACK of this sheet)

Name of Plugging Contractor _____
Address _____

STATE OF KANSAS, COUNTY OF SEDGWICK, ss.
Richard A. Shelley (employee of owner) or (owner or operator) of the above-described well, being first duly sworn on oath, says: That I have knowledge of the facts, statements, and matters herein contained and the log of the above-described well as filed and that the same are true and correct. So help me God.

(Signature) Richard A. Shelley
205 Miller Building, Wichita, Kansas
(Address)

SUBSCRIBED AND SWORN TO before me this 7 day of June, 19 55

Leona M. Baker
Notary Public.

My commission expires March 24, 1956

24-7368-6 3-53-20M

PLUGGING
FILED SEC. 35 T. 20 S. R. 10 W.
BOOK PAGE 24 LINE 33

COMPANY: Shelley-Miller Drilling, Inc.
205 Miller Building
Wichita, Kansas

Rotary Drilling Commenced: 5-23-55
Rotary Drilling Completed: 6-2-55

LOCATION: Burns No. 1
SE SE NW 35-20S-10W
Rice County, Kansas

CONTRACTOR: Shelley-Miller Drilling, Inc.
205 Miller Building
Wichita, Kansas

CASING RECORD: 8 5/8" 28# Slms Casing Set @ 190' cemented with
150 sacks cement.

L O G

(Measurements from top of Rotary Bushing to bottom of formation)

Sand	35
Clay & Shale	80
Red Bed	351
Anhydrite	376
Red Bed & Shells	615
Shale & Shells	1,065
Salt Bed	1,220
Shale & Lime	1,275
Lime & Shale	2,970
Lime	3,374 Rotary T. D.

The undersigned, Richard A. Shelley, President of Shelley-Miller Drilling, Inc., hereby certifies in behalf of said company, that the above log is a true and correct log of the formation encountered in drilling the above well as reflected by the Daily Drilling Reports.

SHELLEY-MILLER DRILLING, INC.

By Richard A. Shelley
President

STATE OF KANSAS)
COUNTY OF SEDGWICK) SS

BE IT REMEMBERED, that on this 7th day of June, 1955, before me, the undersigned, a Notary Public, duly commissioned in and for the county and state aforesaid, came Richard A. Shelley, President, and known to me to be the same person who executed the foregoing instrument of writing in behalf of Shelley-Miller Drilling, Inc., as President of said company, and he duly acknowledged the execution of the same for himself and for said company.

IN WITNESS WHEREOF, I have hereunto set my hand and official seal on the day and year last above written.

Leona M. Baker
Notary Public

My Commission Expires:
March 24, 1956

STATE OF KANSAS
JUN 9 1955
CONSERVATION DIVISION
Wichita, Kansas

PLUGGING
WELL SEC 35 20 R 10W
BODY PAGE 124 LINE 33