


STATE OF KANSAS
STATE CORPORATION COMMISSION

Give All Information Completely
Make Required Affidavit
Mail or Deliver Report to
Conservation Division
State Corporation Commission
211 No. Broadway
Wichita, Kansas

WELL PLUGGING RECORD

NORTH

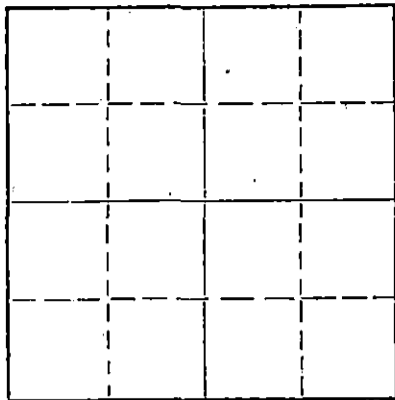

Locate well correctly on above
Section Plat

Rice County, Sec. 34 Twp. 20S Rge. 10W (X) (W)
Location as "NE/CNW/SW" or footage from lines SW NW NE
Lease Owner High Plains Production Co. and Oil & Gas Futures
Lease Name Burns Well No. #1
Office Address 300 Insurance Building, Wichita 2, Kansas
Character of Well (completed as Oil, Gas or Dry Hole) Dry & Abandoned
Date well completed: October 22, 19 63
Application for plugging filed: October 30, 19 63
Application for plugging approved: 19
Plugging commenced: 19
Plugging completed: 19
Reason for abandonment of well or producing formation Dry Wildcat

If a producing well is abandoned, date of last production 19
Was permission obtained from the Conservation Division or its agents before plugging was commenced? Yes

Name of Conservation Agent who supervised plugging of this well Gilbert J. Toman
Producing formation None Depth to top Bottom Total Depth of Well 3363 Feet
Show depth and thickness of all water, oil and gas formations.

OIL, GAS OR WATER RECORDS

CASING RECORD

FORMATION	CONTENT	FROM	TO	SIZE	PUT IN	PULLED OUT

Describe in detail the manner in which the well was plugged, indicating where the mud fluid was placed and the method or methods used in introducing it into the hole. If cement or other plugs were used, state the character of same and depth placed, from feet to feet for each plug set.

Bottom plug @ 250' with 20 sacks.
Top plug @ 35' with 10 sacks.

RECEIVED
STATE CORPORATION COMMISSION

NOV 6 1963

CONSERVATION DIVISION
Wichita, Kansas

(If additional description is necessary, use BACK of this sheet)
Name of Plugging Contractor Garvey Drilling Co.
Address Great Bend, Kansas

STATE OF Kansas COUNTY OF Sedgwick ss.
Thornton E. Anderson (employee of owner) or (owner or operator) of the above-described well, being first duly sworn on oath, says: That I have knowledge of the facts, statements, and matters herein contained and the log of the above-described well as filed and that the same are true and correct. So help me God.

(Signature) Thornton E. Anderson
300 Insurance Building, Wichita, Kansas (Address)

SUBSCRIBED AND SWORN TO before me this 31st day of October, 19 63

My commission expires October 22, 1967. Betty J. Sharp Notary Public.

WELL LOG

15.159.00665.0000

COMPANY Oil and Gas Futures, LTD.

SEC. 34 T. 20S R. 10W

FARM Burns NO. 1


LOC. C-SW-NW-NE

TOTAL DEPTH 3363'

COUNTY Rice

COMM. 10-14-63 COMP. 10-22-63

CONTRACTOR Garvey Drilling Company

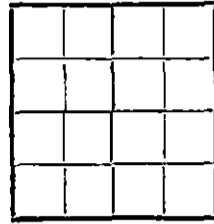

CASING 8 5/8" @ 262.87' w/225 sx

ELEVATION 1716' DF

PRODUCTION D & A

FIGURES INDICATE BOTTOM OF FORMATIONS

- 65' Sand
- 264' Shale and Shells
- 360' Red Bed and Shale
- 378' Anhydrite
- 1230' Shale and Shells
- 1475' Lime and Shale
- 1700' Shale and Lime Streaks
- 2285' Shale and Lime
- 2500' Shale
- 2535' Sand
- 2585' Shale and Lime
- 2680' Lime
- 2790' Cherty Lime and Shale
- 3185' Lime
- 3276' Lime (Shaley)
- 3290' Lime
- 3319' Sandy Shale and Lime
- 3353' Lime and Shale
- 3363' Arbuckle
- 3363' RTD

RECEIVED
STATE CORPORATION COMMISSION

NOV 6 1963

CONSERVATION DIVISION
Wichita, Kansas

State of Kansas }
County of Barton } ss

I, Sam N. Stephens of Garvey Drilling Company

upon oath state the above and foregoing is a true and correct copy of the log of the Burns #1 well.

Sam N. Stephens

Subscribed and sworn to before me this 1st day of November 1963

My Commission Expires: September 23rd, 1967

Howard Spencer
NOTARY PUBLIC