


WELL PLUGGING RECORD

Give All Information Completely  
Make Required Affidavit  
Mail or Deliver Report to:  
Conservation Division  
State Corporation Commission  
800 Bittling Building  
Wichita, Kansas

NORTH

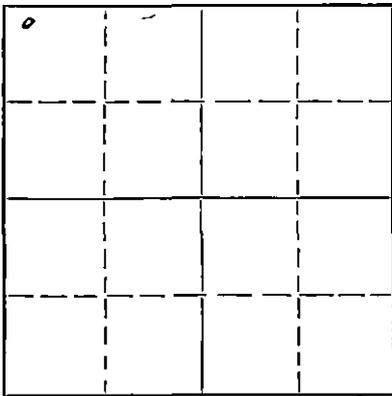

Locate well correctly on above  
Section Plat

Rice County. Sec. 30 Twp. 20 Rge. (E) 10 (W)  
Location as "NE/CNW $\frac{1}{4}$ SW $\frac{1}{4}$ " or footage from lines C of NW NW NW  
Lease Owner Gulf Oil Corporation  
Lease Name C. Yeo Well No. 1  
Office Address Box 661 Tulsa, Oklahoma  
Character of Well (completed as Oil, Gas or Dry Hole) Oil  
Date well completed 3-19-39 19  
Application for plugging filed 3-26-53 19  
Application for plugging approved 3-26-53 19  
Plugging commenced 4-5-53 19  
Plugging completed 4-19-53 19  
Reason for abandonment of well or producing formation Not economical to operate  
If a producing well is abandoned, date of last production 10-18-52 19  
Was permission obtained from the Conservation Division or its agents before plugging was commenced? Yes

Name of Conservation Agent who supervised plugging of this well Ruel Durkee  
Producing formation Arbuckle Depth to top 3300 Bottom 3310 Total Depth of Well 3310 Feet  
Show depth and thickness of all water, oil and gas formations.

OIL, GAS OR WATER RECORDS

CASING RECORD

Formation	Content	From	To	Size	Put In	Pulled Out
				16"	43'	None
				9-5/8"	197'	None
				7"	3301'	1562'

Describe in detail the manner in which the well was plugged, indicating where the mud fluid was placed and the method or methods used in introducing it into the hole. If cement or other plugs were used, state the character of same and depth placed, from \_\_\_\_\_ feet to \_\_\_\_\_ feet for each plug set.

Plugged back with sand 3310' to 3280'. Dumped 6 sacks cement at 3280'.  
Recovered total of 52 lbs. 1562' of 7" csg. Mudded hole to 190'.  
Set 10' rock bridge. Dumped 15 sacks cement on bridge. Filled hole  
with mud to 15' of surface. Capped with 10 sacks cement.

(If additional description is necessary, use BACK of this sheet)

Name of Plugging Contractor C. E. Skull Casing Pulling Company  
Address Great Bend, Kansas

STATE OF Kansas, COUNTY OF Rice, SS.  
W. H. Duley (employee of owner) of the above-described well,  
being first duly sworn on oath, says: That I have knowledge of the facts, statements, and matters herein contained and the log of the above-described well as filed and that the same are true and correct. So help me God.

(Signature) W. H. Duley

Box 544 Chase, Kansas (Address)

SUBSCRIBED AND SWORN to before me this 24th day of April, 1953

My commission expires April 14, 1956

Notary Public

PLUGGING  
FILE SEC 30 T 20 R 10W  
BOOK PAGE 22 LINE 17


4-27-53

0' to 51' Surface  
 68 Sand  
 137 Blue shale  
 202 Red shale  
 480 Red bed  
 998 Shale & shells  
 1090 Salt & shells  
 1240 Salt  
 1260 Shale & lime  
 1345 Anhydrite  
 1375 Lime & shale breaks  
 1435 Anhydrite & lime  
 1447 Blue shale & shells  
 1470 Shale & lime

DEPTH	DESCRIPTION	SIZE	WEIGHT	THD.	CLASS	MAKE	DEPTH	SET AT	BACK	LB
1497	Hard lime									
1553	Lime & shale breaks									
1578	Gray lime									
1595	Sandy lime									
1598	Shale & lime									
1648	Lime									
1693	Shale & hard lime									
1745	Lime & shale									
1761	Lime & shale breaks									
1800	Blue shale & shells									
1816	Lime									

1820 Broken lime & red shale  
 1836 Broken lime & blue shale  
 1927 Lime & shale  
 1970 Sandy lime & shale  
 2020 Shale & lime  
 2108 Blue shale & sandy lime  
 2165 Blue shale & shells  
 2200 Lime  
 2305 Shale & lime  
 2345 Shale & lime shells  
 2352 Lime  
 2400 Blue shale & shells  
 2520 Lime & shale  
 2578 Blue shale & lime  
 2606 Lime & blue shale breaks  
 2615 Black shale & lime  
 2631 Broken hard lime  
 2667 Lime & shale breaks  
 2690 Lime & shale  
 2703 Blue shale  
 2705 Lime & shale breaks  
 2730 Lime & shale  
 2752 Lime  
 2761 Hard lime & chert  
 2782 Shale  
 2786 Hard lime  
 2866 Lime  
 2893 Lime & shale breaks  
 2935 Lime & shale  
 2979 Blue & brown shale & lime shells  
 2982 Lime  
 3000 Blue shale & lime  
 3022 Blue shale & shells  
 3048 Lime & shale  
 3086 Lime & shale breaks  
 3087 Lime  
 3098 Lime  
 3135 Lime & shale  
 3180 Lime  
 3274 Lime  
 3291 Blue shale & lime  
 3302 Blue shale & lime  
 3310 Lime

TOTAL DEPTH

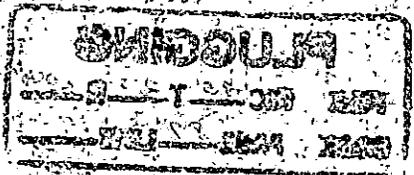

WELL NO. **1** LEASE **Clyde Yeo** COMPANY **Gulf Oil Corporation** A.F.E. **3158**  
 DATE DRILLING BEGAN **2-14-39** WELL COMPLETED **3-19-39** FIRST PRODUCTION **3-19-39**  
 SAND RECORD **Arbuckle Lime, 3300' - 3310'** TOTAL DEPTH **3310'**

INITIAL PRODUCTION OIL: "P" **337 Barrels. (112.32 in 8 hours)** Corrected Gravity **1.8**  
 WATER: **268 Barrels. (89.28 in 8 hours)**

CASING RECORD

SIZE	WEIGHT	THD	CLASS	MAKE	SET AT DEPTH	BACKS CEMENT	LBS. GAL. CHLO.	PULLED	LEFT IN	TO	BY	DATE
16"	75	8	New	National	13'	60	100	--	13'	Center		
				Sale. St.						NW	NE	NW
9-5/8"	36	8	New	SC LY	197'	120	300	--	197'			
7"	*	10	*	*	3301'	125	--	--	3301'			
37 joints	2 1/2	0-1	Lapweld	1 joint	2 1/2	New	J&L Seamless			Rice County,		
Steel	65 joints	2 1/2	BH	Seamless	Steel.					Kansas		

(\*) F. FLOWING NATURALLY; L. AIR GAS LIFT; S. SWABBING; P. PUMPING. ELEVATION **DE 1743'**  
**BY 1739.5'**

RECEIVED

**PLUGGING**  
 REC 301 T 20 R 10W  
 BOX HAS 32 LINE 12