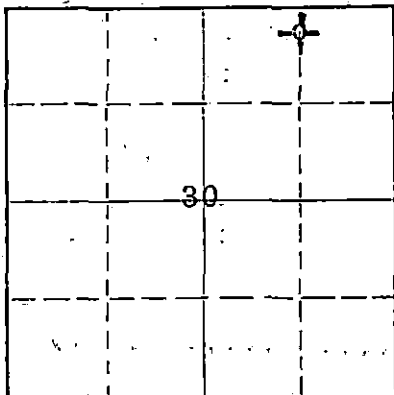


Give All Information Completely
Make Required Affidavit
Mail or Deliver Report to:
Conservation Division
State Corporation Commission
211 No. Broadway
Wichita, Kansas

WELL PLUGGING RECORD

NORTH

Locate well correctly on above
Section Plat

Rice County, Sec. 30 Twp. 20S Rge. 10W (X) (W)
Location as "NE/CNW/SW" or footage from lines C N/2 N/2 NE
Lease Owner D. R. Lauck Oil Company, Inc.
Lease Name Yeo Well No. 1
Office Address 301 S. Broadway, Wichita, Kansas
Character of Well (completed as Oil, Gas or Dry Hole) Dry Hole
Date well completed June 23, 19 62
Application for plugging filed June 23, 19 62
Application for plugging approved June 23, 19 62
Plugging commenced June 23, 19 62
Plugging completed June 23, 19 62
Reason for abandonment of well or producing formation Dry Hole

If a producing well is abandoned, date of last production 19
Was permission obtained from the Conservation Division or its agents before plugging was commenced? Yes

Name of Conservation Agent who supervised plugging of this well Gilbert Toland
Producing formation Depth to top Bottom Total Depth of Well 3400 Feet
Show depth and thickness of all water, oil and gas formations.

OIL, GAS OR WATER RECORDS

CASING RECORD

FORMATION	CONTENT	FROM	TO	SIZE	PUT IN	PULLED OUT
	8-5/8"	0	201'	8-5/8"	201'	None

Describe in detail the manner in which the well was plugged, indicating where the mud fluid was placed and the method or methods used in introducing it into the hole. If cement or other plugs were used, state the character of same and depth placed, from feet to feet for each plug set.

3400-190' - Mud
190-186' - Plug
186- 30' - 20 Sacks Cement & Mud
30- 26' - Plug
26- 6' - Cement (Bottom of Cellar)

RECEIVED
STATE CORPORATION COMMISSION

7-10-62 JUL 11 1962

CONSERVATION DIVISION
Wichita, Kansas

(If additional description is necessary, use BACK of this sheet)

Name of Plugging Contractor Sun Cementing Co.
Address Great Bend, Kansas

STATE OF KANSAS, COUNTY OF SEDGWICK, ss.

John H. Knightley (employee of owner) or (owner or operator) of the above-described well, being first duly sworn on oath, says: That I have knowledge of the facts, statements, and matters herein contained and the log of the above-described well as filed and that the same are true and correct. So help me God.

(Signature)

301 S. Broadway, Wichita, Kansas
(Address)

SUBSCRIBED AND SWORN to before me this 9th day of July, 1962.

My commission expires March 12, 1963.

Stella J. Bodine
Notary Public.

D. R. Lauck Oil Company, Inc.

Yeo #1

C N/2 N/2 NE Sec. 30-20S-10W
Rice County, KansasCommenced: June 16, 1962
Completed: June 24, 1962Casing Record: 201' 8-5/8" Cemented w/180 sacks cement,
4 sacks Calcium Chloride.

Elevation: GL 1734; DF 1737; KB 1739.

Drillers Log

Tops

Sand	60
Shale	201
Red Bed	416
Anhydrite	430
Lime	440
Shale & Shells	1200
Shale & Lime	1385
Anhydrite & Shells	1465
Lime, Shale & Shells	1640
Lime & Shale	1840
Lime	1940
Shale & Lime	2320
Broken Lime & Shale	2525
Lime & Shale	2580
Lime	2670
Lime & Shale	2755
Lime	2841
Heebner	2845
Lime & Shale	2895
Shale & Lime	3010
Lime	3265
Shale	3294
Arbuckle Lime	3400 RTD

Sample

Heebner	2841 (-1102)
Toronto	2858 (-1119)
Douglas	2875 (-1136)
Brown Lime	2970 (-1231)
Lansing	2990 (-1251)
Simpson	3273 (-1534)
Arbuckle	3294 (-1555)
Total Depth	3400 (-1661)

DST #1 (S) 3041-3085, Open 1 hour w/fair
blow thruout. Recovered 120' gas,
65' slightly oil and gas cut mud.
ISIP 10#/20 min. FSIP 8#/30 min.
IFP 3#. FFP 7#.

DST #2 (S) 3290-3300, Open 1 hour w/fair
blow thruout. Recovered 150' clean
oil, 115' watery oil (50% water),
20' water. ISIP 1058#/30 min.
FSIP 1010#/30 min. IFP 59#. FFP 149#.

D&A

RECEIVED
STATE CORPORATION COMMISSION

JUL 10 1962

CONSERVATION DIVISION
Wichita, Kansas