

WELL PLUGGING RECORD

Give All Information Completely
Make Required Affidavit
Mail or Deliver Report to:
Conservation Division
State Corporation Commission
800 Bittling Building
Wichita, Kansas

Rice County. Sec. 30 Twp. 20S Rge. 10 #####(W)

Location as "NE/CNW $\frac{1}{4}$ SW $\frac{1}{4}$ " or footage from lines N/2 NW/4 NE/4

Lease Owner Anderson-Prichard Oil Corporation

Lease Name Ye0 "A" Well No. 2

Office Address Box 142 - Great Bend, Kansas

Character of Well (completed as Oil, Gas or Dry Hole) Oil Well

Date well completed April 29, 19 42

Application for plugging filed November 30, 19 50

Application for plugging approved December 1, 19 50

Plugging commenced December 3, 19 50

Plugging completed December 9, 19 50

Reason for abandonment of well or producing formation Non-Commercial

If a producing well is abandoned, date of last production Sept. 14, 19 48

Was permission obtained from the Conservation Division or its agents before plugging was commenced? Yes

Name of Conservation Agent who supervised plugging of this well Mr. Ruel Durkee

Producing formation Arbuckle Depth to top 3294 Bottom Total Depth of Well PB3294 Feet

Show depth and thickness of all water, oil and gas formations.

OIL, GAS OR WATER RECORDS

CASING RECORD

Formation	Content	From	To	Size	Put In	Pulled Out
				8-5/8	198'	none
				5-1/2	3295'	2300'

Describe in detail the manner in which the well was plugged, indicating where the mud fluid was placed and the method or methods used in introducing it into the hole. If cement or other plugs were used, state the character of same and depth placed, from _____ feet to _____ feet for each plug set.

Filled with crushed rock to 3280'
Dumped 6 sax cement
Shot Casing off at 2311', Pulled pipe out
Filled hole with heavy mud to 198'
Set permanent rock bridge
dumped 20 sax cement filled hole to 30'
Mixed 10 sax cement for cap on well.

RECEIVED
STATE CORPORATION COMMISSION
DEC-20-1950
CONSERVATION DIVISION
Wichita, Kansas

(If additional description is necessary, use BACK of this sheet)

Correspondence regarding this well should be addressed to W. J. Dearen % Anderson-Prichard Oil Corp.
Address Box 142 - Great Bend, Kansas

STATE OF KANSAS, COUNTY OF BARTON, ss.

Gerald M. Dougherty (employee of owner) of the above-described well, being first duly sworn on oath, says: That I have knowledge of the facts, statements, and matters herein contained and the log of the above-described well as filed and that the same are true and correct. So help me God.

(Signature) Gerald M. Dougherty

Box 142 - Great Bend, Kansas (Address)

SUBSCRIBED AND SWORN to before me this 19th day of December, 19 50

Verdella M. Hankins Notary Public.

My commission expires December 4, 1954

PLUGGING
FILE SEC 30 T 20 S R 10 W
BOOK PAGE 46 LINE 13

WELL RECORD

ANDERSON-PRICHARD OIL CORPORATION, OKLAHOMA CITY,
OKLAHOMA.

WELL NO. WA-2 - C 1/2 E 1/4 E 1/4 Section 30-203-10W,
Rice County, Kansas.

CONTRACTOR - MERCURY DRILLING COMPANY, TULSA, OKLA.


DRILLING COMMENCED - April 3, 1942

DRILLING COMPLETED - April 22, 1942

DEPTH - 0' to 3297'
CABLE TOOLS to 3297' T.D.
CASING RECORDED:

(198')
RUE 10 Jts. 8 1/2" O.D. Surface Pipe-
Cemented w/125 sacks cement.

Set and cemented 5 1/2" O.D. at 3294' w/ 100
sacks cement.

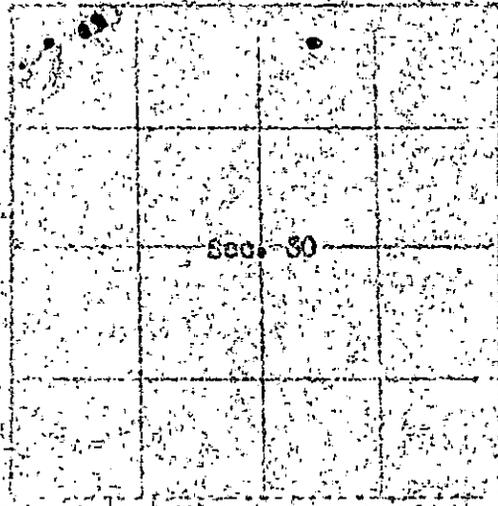

10W

Section 30, Township 25 South,
Range 10 West, Rice County,
Kansas.

FORMATION RECORD

FORMATION	TOP	BOTTOM
Sand	0'	75'
Shale & Shells	75	133
Shale & Red Rock	133	205
Shells & Red Rock	205	415
Anhydrite	415	442
Shale & Shells	442	910
Salt	910	1030
Salt & Shale	1030	1150
Shale & Shells	1150	1240
Broken Lino	1240	1542
Lino & Shale	1542	1595
Sand	1595	1630
Shale & Shells	1630	1900
Lino	1900	2001
Broken Lino	2001	2028
Shale & Shells	2028	2190
Shale & Lino Shells	2190	2390
Shale & Shells	2390	2592
Lino	2592	2850
Lino & Shale	2850	3028
Lino	3028	3203
Shale	3203	3225
Lino & Shale	3225	3272
Lino	3272	3291
Chert	3291	3293
Dolomite Lino	3293	3297 T.D.

We hereby certify that the above is a true and correct record of the log on the
Well WA-2 in the Center of North Half of the Northwest Quarter of the Northeast
Quarter of Section 30, Township 25 South, Range 10 West, Rice County, Kansas.

MERCURY DRILLING COMPANY

Chester H. Westfall

CHESTER H. WESTFALL, PRESIDENT

ATTEST:

R.H. Cook
Asst. Secretary

RECORDED
STATE CORPORATION
DEC 1 - 1950
CONSERVATION DIVISION
Wichita, Kansas

PLUGGING
FILE SEC 30-20 R/10W
BOOK PAGE 46 LINE 13