

9


STATE OF KANSAS  
STATE CORPORATION COMMISSION

Give All Information Completely  
Make Required Affidavit  
Mail or Deliver Report to:  
Conservation Division,  
State Corporation Commission  
211 No. Broadway  
Wichita, Kansas

WELL PLUGGING RECORD

RICE County, Sec. 16 Twp. 20S Rge. 8W (X) (W)  
Location as "NE/CNW/SE" or footage from lines C SE SE  
Lease Owner Ben C. W. Hyde, Jr.  
Lease Name TAYLOR Well No. 1  
Office Address 4722 Broadway, Kansas City 12, Missouri  
Character of Well (completed as Oil, Gas or Dry Hole) DRY HOLE  
Date well completed May 31, 1964  
Application for plugging filed May 31, 1964  
Application for plugging approved May 31, 1964  
Plugging commenced May 31, 1964  
Plugging completed May 31, 1964  
Reason for abandonment of well or producing formation DRY HOLE

NORTH

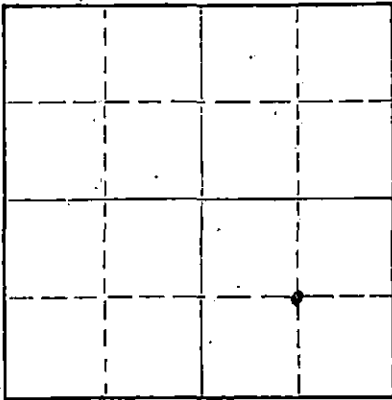

Locate well correctly on above  
Section Plat

If a producing well is abandoned, date of last production 19  
Was permission obtained from the Conservation Division or its agents before plugging was commenced? yes

Name of Conservation Agent who supervised plugging of this well Gilbert Toman  
Producing formation \_\_\_\_\_ Depth to top \_\_\_\_\_ Bottom \_\_\_\_\_ Total Depth of Well 3504' Feet  
Show depth and thickness of all water, oil and gas formations.

OIL, GAS OR WATER RECORDS

CASING RECORD

FORMATION	CONTENT	FROM	TO	SIZE	PUT IN	PULLED OUT

Describe in detail the manner in which the well was plugged, indicating where the mud fluid was placed and the method or methods used in introducing it into the hole. If cement or other plugs were used, state the character of same and depth placed, from \_\_\_\_\_ feet to \_\_\_\_\_ feet for each plug set.

Set bottom plug @ 210' 1/4 sacks hulls  
and 20 sacks cement. Mud to 40'.

Set top plug @ 40' with 10 sacks cement.

Two sacks in Rat Hole

6-3-64

UNDER THE SUPERVISION OF GILBERT TOMAN

RECEIVED  
STATE CORPORATION COMMISSION

JUN 3 1964

CONSERVATION DIVISION  
Wichita, Kansas

(If additional description is necessary, use BACK of this sheet)  
Name of Plugging Contractor ISERN DRILLING COMPANY  
Address Box 486, ELLINWOOD, KANSAS

STATE OF KANSAS, COUNTY OF BARTON, ss.  
Dean Wells (employee of owner) or (owner or operator) of the above-described well, being first duly sworn on oath, says: That I have knowledge of the facts, statements, and matters herein contained and the log of the above-described well as filed and that the same are true and correct. So help me God.

(Signature) Dean Wells

BOX 486, ELLINWOOD, KANSAS  
(Address)

SUBSCRIBED AND SWORN TO before me this 2nd day of June, 19 64

George A. Meyer  
George A. Meyer, Notary Public.

My commission expires February 10, 1967.

R

WELL LOG

HYDE'S, TAYLOR #1  
 C SE SE, Sec. 16-20S-8W  
 Rice County, Kansas

FIGURES INDICATE BOTTOM OF FORMATION:

ELEVATION: 1654' K.B.

PIPE RECORD:  
 8 5/8" set @ 219'  
 with 200 sacks.

ROTARY COMMENCED: 5-23-64  
 ROTARY COMPLETED: 5-31-64

TOPS:  
 Heebner 2724  
 Brown Lime 2865  
 Lansing 2901  
 Conglomerate Chert 3260  
 Kinderhook Lime 3385  
 Kinderhook Sand 3460  
 Maquoketa 3495  
 Total Depth 3504

0	to	10	cellar
		100	sand
		1000	shale & shells
		1075	salt
		1430	shale & shells
		1775	lime & shale
		2440	shale & shells
		3270	lime & shale
		3290	shale & lime
		3405	lime & shale
		3477	lime & sand
		3504	Rotary Total Depth

**RECEIVED**  
 STATE CORPORATION COMMISSION

JUN 3 1964


CONSERVATION DIVISION  
 Wichita, Kansas

STATE OF KANSAS )  
 ) ss  
 COUNTY OF BARTON)

I, Dean Wells, Partner of Isern Drilling Company, contractor for the above described well, being first duly sworn on oath, declare: That I have knowledge of the facts, statements and matter herein contained pertaining to the log of the above-described well, as filed, and that the same are true and correct.

  
 \_\_\_\_\_  
 Dean Wells

Subscribed and sworn to before me on this 2nd day of June, 1964.

  
 \_\_\_\_\_  
 George A. Meyer, Notary Public

My commission expires February 10, 1967.