

STATE OF KANSAS
STATE CORPORATION COMMISSION

WELL PLUGGING RECORD

Give All Information Completely
Make Required Affidavit
Mail or Deliver Report to:
Conservation Division
State Corporation Commission
211 No. Broadway
Wichita, Kansas

Rice County. Sec. 16 Twp. 20S Rge. 8W (E) (W)
Location as "NE/CNW%SW%" or footage from lines C W/2 NE/4

Lease Owner Ben C. W. Hyde, Jr.

Lease Name TOBIAS "B" Well No. 2

Office Address 4722 Broadway, Kansas City, Missouri 64112

Character of Well (completed as Oil, Gas or Dry Hole) Dry Hole

Date well completed February 28 1966

Application for plugging filed February 28 1966

Application for plugging approved February 28 1966


Plugging commenced February 28 1966

Plugging completed February 28 1966

Reason for abandonment of well or producing formation Dry Hole

If a producing well is abandoned, date of last production _____ 19____

Was permission obtained from the Conservation Division or its agents before plugging was commenced? yes

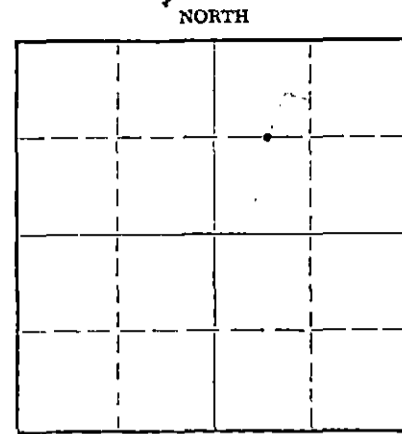

Locate well correctly on above Section Plat

Name of Conservation Agent who supervised plugging of this well Gilbert Toman

Producing formation _____ Depth to top _____ Bottom _____ Total Depth of Well 3485 Feet

Show depth and thickness of all water, oil and gas formations.

OIL, GAS OR WATER RECORDS

CASING RECORD

FORMATION	CONTENT	FROM	TO	SIZE	PUT IN	PULLED OUT

Describe in detail the manner in which the well was plugged, indicating where the mud fluid was placed and the method or methods used in introducing it into the hole. If cement or other plugs were used, state the character of same and depth placed, from _____ feet to _____ feet for each plug set.

plug 20 sacks cemented 1/4 sacks hulls at 220'
and filled hole up with mud to 40' Plug 1/2 sacks
hulls and 10 sacks cement.
Two sacks cement in Rat Hole.

RECEIVED
STATE CORPORATION COMMISSION

MAR 2 1966

CONSERVATION DIVISION
Wichita, Kansas

(If additional description is necessary, use BACK of this sheet)

Name of Plugging Contractor ISERN DRILLING COMPANY

Address BOX 486, ELLINWOOD, KANSAS

STATE OF KANSAS, COUNTY OF BARTON, ss.
W. F. Banks (employee of owner) or ~~(owner)~~ of the above-described

well, being first duly sworn on oath, says: That I have knowledge of the facts, statements, and matters herein contained and the log of the above-described well as filed and that the same are true and correct. So help me God

(Signature) W. F. Banks

Box 486, Ellinwood, Kansas
(Address)

SUBSCRIBED AND SWORN to before me this 28th day of February, 1966

My commission expires February 20 10, 1967.

George A. Meyer
George A. Meyer, Notary Public.

WELL LOG

Ben C. W. Hyde, Jr.
 TOBIAS "B" #2, C W/2 NE/4
 Section 16-20S-8W
 Rice County, Kansas

Figures indicate bottom of formation:

ELEVATION: 1655' KB

PIPE RECORD:
 8 5/8" set @ 228'
 with 225 sacks cement.

ROTARY COMMENCED: 2-21-66
 ROTARY COMPLETED: 2-28-66

TOPS:

Heebner	2720
Brown Lime	2862
Lansing	2899
Conglomerate	3280
Kinderhook Lime	3359
Kinderhook Sand	3432
Maquoketa	3473
Log Total Depth	3486

0 to 10	cellar
90	sand
229	red rock
850	shale & shells
1050	salt
1400	shale & shells
1577	lime & shale
2435	shale & shells
3444	lime & shale
3455	Sand
3485	Rotary Total Depth

RECEIVED
 STATE CORPORATION COMMISSION

MAR 2 1966

CONSERVATION DIVISION
 STATE OF KANSAS

STATE OF KANSAS)
 COUNTY OF BARTON) ss

I, Dean Wells, Partner of Isern Drilling Company, contractor for the above-described well, being first duly sworn on oath, declare: That I have knowledge of the facts, statements and matter herein contained pertaining to the log of the above-described well, as filed, and that the same are true and correct.

Dean Wells
 Dean Wells, Partner

Subscribed and sworn to before me on this 1 day of March, 1966.

George A Meyer
 Notary Public

My Commission expires February 10, 1967.