


WELL PLUGGING RECORD

Give All Information Completely
Make Required Affidavit
Mail or Deliver Report to:
Conservation Division
State Corporation Commission
211 No. Broadway
Wichita, Kansas

Rice County. Sec. 16 Twp. 20S Rge. 8W (H) (W)

NORTH

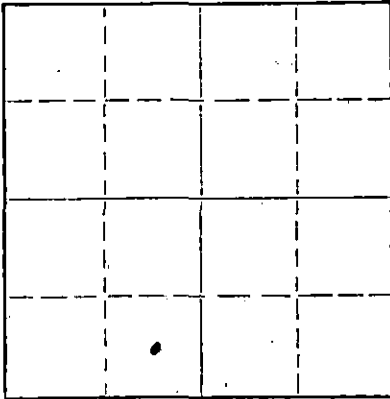

Locate well correctly on above
Section Plat

Location as "NE/CNW/SW" or footage from lines SE SW
Lease Owner HYDE-ISERN-WELLS
Lease Name SENTNEY Well No. 1
Office Address BOX 486, ELLINWOOD, KANSAS
Character of Well (completed as Oil, Gas or Dry Hole) DRY HOLE
Date well completed May 15 1964
Application for plugging filed May 15 1964
Application for plugging approved May 15 1964
Plugging commenced May 15 1964
Plugging completed May 15 1964
Reason for abandonment of well or producing formation DRY HOLE

If a producing well is abandoned, date of last production 19
Was permission obtained from the Conservation Division or its agents before plugging was commenced? yes

Name of Conservation Agent who supervised plugging of this well
Producing formation Depth to top Bottom Total Depth of Well 3495 Feet
Show depth and thickness of all water, oil and gas formations.

OIL, GAS OR WATER RECORDS

CASING RECORD

FORMATION	CONTENT	FROM	TO	SIZE	PUT IN	PULLED OUT

Describe in detail the manner in which the well was plugged, indicating where the mud fluid was placed and the method or methods used in introducing it into the hole. If cement or other plugs were used, state the character of same and depth placed, from feet to feet for each plug set.

Mud up to 215' pushed bottom plug down to 215'.

Plugged with 1/4 sacks Hulls & 20 sacks cement

through drill pipe. Mud up to 40' set Top plug

at 40' with 10 sacks cement & hulls.

2 sacks cement in Rat Hole.

RECEIVED
STATE CORPORATION COMMISSION

MAY 20 1964

CONSERVATION DIVISION
Wichita, Kansas

(If additional description is necessary, use BACK of this sheet)

Name of Plugging Contractor ISERN DRILLING COMPANY
Address BOX 486, Ellinwood, Kansas

STATE OF KANSAS, COUNTY OF BARTON, ss.
Richard Hogg (employee of owner) or (owner or operator) of the above-described

well, being first duly sworn on oath, says: That I have knowledge of the facts, statements, and matters herein contained and the log of the above-described well as filed and that the same are true and correct. So help me God.

(Signature) R. H. Hogg

R. R. #1 Ellinwood, Kansas
(Address)

SUBSCRIBED AND SWORN TO before me this 18th day of May, 1964

My commission expires February, 10, 1967

George A. Meyer
Notary Public

WELL LOG

HYDE-ISERN, SENTNEY #1
SE SW, Section 16-20S-8W
Rice County, Kansas

Figures indicate bottom of formation:

ELEVATION: 1659' KB

PIPE RECORD:
8 5/8" set at 225'
with 200 sacks cement.

ROTARY COMMENCED: 5-8 -64
ROTARY COMPLETED: 5-15-64

TOPS:

Heebner	2727
Brown Lime	2866
Lansing	2904
Cored from 3275-3292 (recovered 17' of shale)	
Kinderhook Lime	3366
Sand	3416
Maquoketa	3478

0	to	10	cellar
		100	sand
		130	shale
		700	shale & shells
		850	shale
		1075	salt
		1380	shale & shells
		1940	lime & shale
		2435	shale & shells
		2740	lime & shale
		2810	shale
		3125	lime & shale
		3180	lime
		3495	lime & shale
		3495	rotary total depth

RECEIVED
STATE CORPORATION COMMISSION

MAY 20 1964

STATE OF KANSAS)
COUNTY OF BARTON) ss

CONSERVATION DIVISION
Wichita, Kansas

I, Richard Hogg, Drilling Superintendent for the above-described well, being first duly sworn on oath, declare: That I have knowledge of the facts, statements and matter herein contained pertaining to the log of the above-described well, as filed, and that the same are true and correct.

Richard Hogg
Richard Hogg

Subscribed and sworn to before me on this 18 day of May, 1964.

George A. Meyer
George A. Meyer, Notary Public

My Commission expires February 10, 1967.

WELL LOG

HYDE-ISERN, SEWNEY #1
SE SW, Section 16-20S-8W
Rice County, Kansas

Figures indicate bottom of formation:

ELEVATION: 1659' KB

PIPE RECORD:

8 5/8" set at 225'
with 200 sacks cement.

ROTARY COMMENCED: 5-8 -64

ROTARY COMPLETED: 5-15-64

TOPS:

Heebner	2727
Brown Lime	2866
Lansing	2904
Cored from 3275-3292 (recovered 17' of shale)	
Kinderhook Lime	3366
Sand	3416
Maquoketa	3478

0	to	10	cellar
		100	sand
		130	shale
		700	shale & shells
		850	shale
		1075	salt
		1380	shale & shells
		1940	lime & shale
		2435	shale & shells
		2740	lime & shale
		2810	shale
		3125	lime & shale
		3180	lime
		3495	lime & shale
		3495	rotary total depth

RECEIVED
STATE CORPORATION COMMISSION

MAY 19 1964

CONSERVATION DIVISION
Wichita, Kansas

STATE OF KANSAS)
COUNTY OF BARTON) ss

I, Richard Hogg, Drilling Superintendent for the above-described well, being first duly sworn on oath, declare: That I have knowledge of the facts, statements and matter herein contained pertaining to the log of the above-described well, as filed, and that the same are true and correct.

R. A. Hogg
Richard Hogg

Subscribed and sworn to before me on this 18 day of May, 1964.

George A. Meyer
George A. Meyer, Notary Public

My Commission expires February 10, 1967.