


STATE OF KANSAS
STATE CORPORATION COMMISSION

Give All Information Completely
Make Required Affidavit
Mail or Deliver Report to:
Conservation Division
State Corporation Commission
212 No. Market
Wichita, Kansas

WELL PLUGGING RECORD

Rice County, Sec 23 Twp 20S Rge. 8W (X) (W)
Location as "NE/CNW/SW" or footage from lines Approx. C SE SW
Lease Owner Isern-Wells & Associates
Lease Name Nathan Bundy Well No. 1
Office Address Box 486, Ellinwood, Kansas 67526
Character of Well (completed as Oil, Gas or Dry Hole) Dry Hole
Date well completed October 18 19 67
Application for plugging filed October 18 19 67
Application for plugging approved October 18 19 67
Plugging commenced October 18 19 67
Plugging completed October 18 19 67
Reason for abandonment of well or producing formation Dry Hole

NORTH

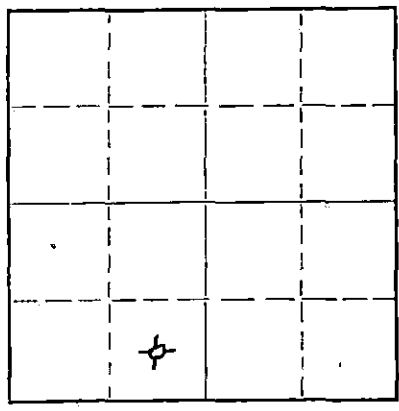

Locate well correctly on above Section Plat

If a producing well is abandoned, date of last production _____ 19 ____
Was permission obtained from the Conservation Division or its agents before plugging was commenced? yes

Name of Conservation Agent who supervised plugging of this well Gilbert Toman
Producing formation _____ Depth to top _____ Bottom _____ Total Depth of Well 3670 Feet
Show depth and thickness of all water, oil and gas formations.

OIL, GAS OR WATER RECORDS

CASING RECORD

FORMATION	CONTENT	FROM	TO	SIZE	PUT IN	PULLED OUT
Red rock		185	251	8 5/8"	248'	NONE

Describe in detail the manner in which the well was plugged, indicating where the mud fluid was placed and the method or methods used in introducing it into the hole. If cement or other plugs were used, state the character of same and depth placed, from _____ feet to _____ feet for each plug set.

Filled hole with mud to 240' 1/4 sack hulls, plug and 25 sacks cement.

Filled hole with mud to 40' 1/4 sack hulls, plug and 10 sacks cement.

Two sacks in Rat Hole.


10-19-67
OCT 19 1967
CONSERVATION DIVISION
WICHITA, KANSAS

(If additional description is necessary, use BACK of this sheet)
Name of Plugging Contractor ISERN DRILLING COMPANY
Address Box 486, Ellinwood, Kansas 67526

STATE OF KANSAS, COUNTY OF BARTON, ss.
W. F. Banks (employee of owner) or (owner or operator) of the above-described well, being first duly sworn on oath, says: That I have knowledge of the facts, statements, and matters herein contained and the log of the above-described well as filed and that the same are true and correct. So help me God.

(Signature) W. F. Banks
Box 486, Ellinwood, Kansas 67526 (Address)

Subscribed and Sworn to before me this 18th day of October, 19 67

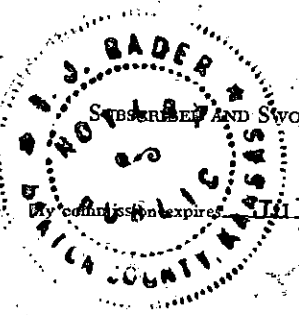

I. J. Rader Notary Public.

W E L L L O G

ISERN - WELLS & ASSOCIATES
NATHAN BUNDY #1, Approx C SE SW
Section 23-20S-8W
Rice County, Kansas

RECEIVED
STATE CORPORATION COMMISSION

OCT 19 1967

CONSERVATION DIVISION
Wichita, Kansas

ELEVATION: 1640' GL
1642' DF
1644' KB

Figures indicate bottom of formation:

PIPE RECORD:

8 5/8" set at 248'
cemented with 250 sacks.

0	to	10	cellar
		10	surface clay & sand
		50	sand
		187	shale & red bed
		251	red rock
		1150	shale, salt & shells
		1300	shale & lime
		1685	lime & shale
		2415	shale & shells
		2725	lime & shale
		2860	shale & Lime
		3670	lime & Shale
		3670	Rotary Total Depth

ROTARY COMMENCED: October 10, 1967
ROTARY COMPLETED: October 18, 1967

TOPS:

Heebner	2714
Brown Lime	2858
Lansing	2898
Conglomerate Chert	3280
Kinderhook Lime	3411
Kinderhook Sand	3464
Maquoketa	3470
Viola	3501
Simpson Sand	3551
Arbuckle	3614

STATE OF KANSAS)
COUNTY OF BARTON) ss

I, Dean Wells, Partner of Isern Drilling Company, contractor for the above-described well, being first duly sworn on oath, declare: That I have knowledge of the facts, statements and matter herein contained pertaining to the log of the above-described well, as filed and that the same are true and correct.

Dean Wells

Dean Wells - Partner

Subscribed and sworn to before me on this 18th day of October, 1967.

My commission expires: 7-7-68.

I. J. Rader

I. J. Rader. Notary Public