


WELL PLUGGING RECORD

Give All Information Completely
Make Required Affidavit
Mail or Deliver Report to:
Conservation Division
State Corporation Commission
800 Bitting Building
Wichita, Kansas

RICE County. Sec. 22 Twp. 20 Rge. (E) 8 (W) 8
Location as "NE/CNW $\frac{1}{4}$ SW $\frac{1}{4}$ " or footage from lines NW SW SE
Lease Owner Hutchins Brothers
Lease Name Hutchins Well No. 1
Office Address Route 2, Lyons, Kansas
Character of Well (completed as Oil, Gas or Dry Hole) Dry Hole
Date well completed September 21 1950
Application for plugging filed September 21 1950
Application for plugging approved September 21 1950
Plugging commenced September 21 1950
Plugging completed September 22 1950
Reason for abandonment of well or producing formation Dry

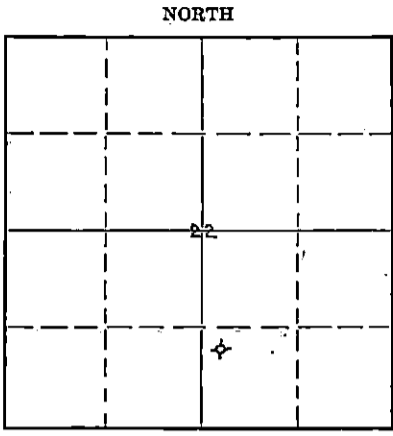

Locate well correctly on above Section Plat

If a producing well is abandoned, date of last production _____ 19____
Was permission obtained from the Conservation Division or its agents before plugging was commenced? Yes

Name of Conservation Agent who supervised plugging of this well C. D. Stough
Producing formation Misener Sand Depth to top 3437' Bottom Not Reached Total Depth of Well 3443 1/2 Feet
Show depth and thickness of all water, oil and gas formations.

OIL, GAS OR WATER RECORDS

CASING RECORD

Formation	Content	From	To	Size	Put In	Pulled Out
				8 5/8	189'	
				5 1/2	3438'	2736'
Misener	Water	3437	3443 1/2			
Conglomerate	Water	3307	3310			

Describe in detail the manner in which the well was plugged, indicating where the mud fluid was placed and the method or methods used in introducing it into the hole. If cement or other plugs were used, state the character of same and depth placed, from _____ feet to _____ feet for each plug set.

3400 Baker Plug
3400 - 3300 Rock Bridge, 5 sacks cement
3300 - 189 Heavy Mud
189 - 127 Rock Bridge, 15 sacks cement
127 - 35 Heavy Mud
35 - Surface Bridge, and 10 sacks cement

STATE CORPORATION COMMISSION

SEP 29 1950

9-29-50

CONSERVATION DIVISION

Wichita, Kansas

(If additional description is necessary, use BACK of this sheet)

Correspondence regarding this well should be addressed to Thos. H. Allan
Address 921 Union National Bank Bldg., Wichita 2, Kansas

STATE OF KANSAS, COUNTY OF SEDGWICK, ss.

THOS. H. ALLAN (employee of owner) or (owner/operator) of the above-described well, being first duly sworn on oath, says: That I have knowledge of the facts, statements, and matters herein contained and the log of the above-described well as filed and that the same are true and correct. So help me God.

(Signature) Thos. H. Allan

921 Union National Bank Bldg., Wichita 2, Kansas
(Address)

SUBSCRIBED AND SWORN to before me this 26th day of September 1950.

Clair M. Stewart

Notary Public.

My commission expires June 14, 1954

PLUGGING
FILE SEC 28 Twp 20 R 2 W
BOOK PAGE 30 LINE 9

8 5/8" @ 189' -- 150 sx
 5 1/2" @ 3438' -- 100 sx -- Pulled 2736

Hutchins Bros. #1 Hutchins
 NW SW SE 20-20-8W
 Rice County, Kansas
 Comm: 9/2/50 Compl: 9/21/50
 Contractor: Tom Allan
 Elevation: 1653 RB
 I.P. D & A

Depth from Rotary Bushings

0 - 20 Surface Soil
 85 Gravel
 188 Red Beds
 200 Anhydrite
 520 Red Beds
 770 Shale
 1020 Salt & Shale
 1220 Anhydrite & Shale
 1420 Lime & Shale
 2520 Shale & Shells
 2720 Lime & Shale Breaks
 2790 Sandy Shale
 2869 Shale
 2877 Lime
 2887 Shale
 2891 Sand
 2899 Shale
 2907 Lime
 2925 Lime & Shale Breaks
 2939 Lime
 2944 Shale
 2962 Lime
 2976 Lime & Shale
 3002 Lime & Shale Breaks
 3043 Lime
 3048 Shale
 3075 Lime, soft
 3080 Shale
 3095 Lime
 3102 Lime & Shale
 3126 Lime, White Ool
 3149 Lime & Shale
 3155 Lime
 3182 Shale with Lime Shells
 3185 Lime, White Ool
 3198 Shale
 3202 Lime
 3218 Shale with Lime Shells
 3228 Lime
 3233 Shale
 3237 Lime
 3253 Shale
 3257 Lime
 3265 Shale
 3277 Lime & Shale
 3280 Shale, Red, Gray & Green
 with Orange Chert
 3296 Shale, Red & Gray

3300 Purple Shale & Chert
 3308 Red Shale & Mud
 3313 Vari-colored Chert
 3347 Shale, Red & Gray
 3355 Shale with Dolomite Streaks
 3418 Lime, Buff Dense
 3437 Shale
 S.L. Corr. Rotary 3440 RB = 3437 1/2 DF Cable
 3443 1/2 (TD) Sand
 3437-40 27 gal. w/hr & Tr. live oil
 3437-43 1/2 164 gal w/hr & Tr. live Oil
 Plug Back to 3400
 Perforated 3307-3310 with 48 Cone Shots
 Filled up 165' of water in 1 hr. 15 min.,
 with Tr. dead Oil

FORMATION TOPS:

188 Top Anhydrite
 2869 Top Iatan
 2899 Top Lansing
 3308 Top Sooy
 3437 Top Misener Sand

I certify that the above is a true and correct copy of the well log on the above test.

Tom Allan

Subscribed and sworn to before me this 26th day of September, 1950

Carl M. Stewart
 Notary Public

My commission expires June 14, 1954

RECEIVED
 REGISTRATION COMMISSION

SEP 29 1950

PLUGGING
 FILE SEC. 221.207.203
 BOOK PAGE 521715-9

REGISTRATION DIVISION
 Wichita, Kansas