


WELL PLUGGING RECORD

Give All Information Completely
Make Required Affidavit
Mail or Deliver Report to:
Conservation Division
State Corporation Commission
211 No. Broadway
Wichita, Kansas

Rice County. Sec. 22 Twp. 20 Rge. 8 (E) (W)
Location as "NE/CNWxSWx" or footage from lines NW SW NE
Lease Owner Sterling Drilling Company, et al
Lease Name Walton "C" Well No. 1
Office Address Sterling, Kansas
Character of Well (completed as Oil, Gas or Dry Hole) Dry Hole
Date well completed June 17, 1956
Application for plugging filed June 17, 1956
Application for plugging approved June 17, 1956
Plugging commenced June 17, 1956
Plugging completed June 17, 1956
Reason for abandonment of well or producing formation

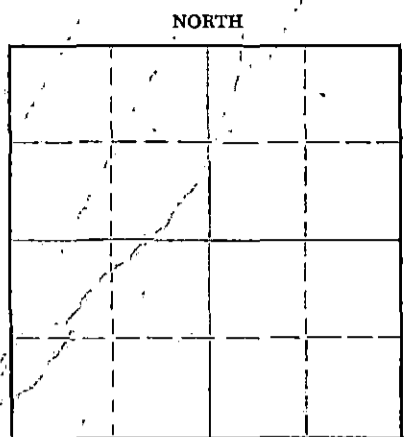

Locate well correctly on above Section Plat

If a producing well is abandoned, date of last production 19
Was permission obtained from the Conservation Division or its agents before plugging was commenced? Yes

Name of Conservation Agent who supervised plugging of this well Ruel Durkee
Producing formation Depth to top Bottom Total Depth of Well 3350 Feet
Show depth and thickness of all water, oil and gas formations.

OIL, GAS OR WATER RECORDS

CASING RECORD

FORMATION	CONTENT	FROM	TO	SIZE	PUT IN	PULLED OUT
				8-5/8"	205'	

Describe in detail the manner in which the well was plugged, indicating where the mud fluid was placed and the method or methods used in introducing it into the hole. If cement or other plugs were used, state the character of same and depth placed, from feet to feet for each plug set.

Filled hole with heavy mud. Set plug at 180' with 15 sacks cement.
Set top plug at 35' with 5 sacks cement.

(If additional description is necessary, use BACK of this sheet)

Name of Plugging Contractor Sterling Drilling Company
Address Sterling, Kansas

STATE OF KANSAS, COUNTY OF RICE, ss.
Rollin Mead (employee of owner) or (owner or operator) of the above-described well, being first duly sworn on oath, says: That I have knowledge of the facts, statements, and matters herein contained and the log of the above-described well as filed and that the same are true and correct. So help me God.

(Signature) *Rollin Mead*
Sterling, Kansas
(Address)

SUBSCRIBED AND SWORN TO before me this 21st day of June, 1956
My Commission Expires Jan. 22, 1958
My commission expires My Commission Expires July 4, 1954

Bernard Landermilk
Notary Public.

PLUGGING
FILE SEC. 22 T. 20 R. 8W
BOOK PAGE 73 LINE 9

RECEIVED
STATE CORPORATION COMMISSION
JUNE 21 1956 6-23-56
CONSERVATION DIVISION
Wichita, Kansas

STERLING DRILLING COMPANY
Sterling, Kansas

WELL LOG-----WALTON "C" #1

Location: NW SW NE, Section 22-20S-8W,
Rice County, Kansas

OWNER: Sterling Drilling Company, et al.
ROTARY DRILLING CONTRACTOR: Sterling Drilling Company

COMMENCED: 6-8-56 (w.r.)
COMPLETED: 6-17-56 (w.r.)

TOTAL DEPTH: 3350'

LOG

CASING RECORD

0-217	Clay, Sand, Shale & Shells	
217-715	Shale & Shells	
715-1150	Shale & Limestone	
1150-1775	Limestone	
1775-1995	Limestone & Shale	
1995-2215	Shale	
2215-2400	Shale & Limestone	
2400-2610	Limestone	
2610-2835	Shale & Limestone	
2835-3267	Limestone	
3267-3330	Conglomerate	
3330-3341	Shale	
3341-3350	Sand	T.D.

Ran 205' of 8-5/8" casing set with
140 sacks cement and 2 sacks calcium
chloride.

PRODUCTION

Plugged & Abandoned

PLUGGING
FILE SEC 22 T. 20 R. 8W
BOOK PAGE 73 LINE 9

RECEIVED
STATE CORPORATION COMMISSION

GENERAL INVESTIGATION
DIVISION