


STATE OF KANSAS
STATE CORPORATION COMMISSION
CONSERVATION DIVISION
P. O. BOX 17027
WICHITA, KANSAS 67217

FORM CP-4

WELL PLUGGING RECORD

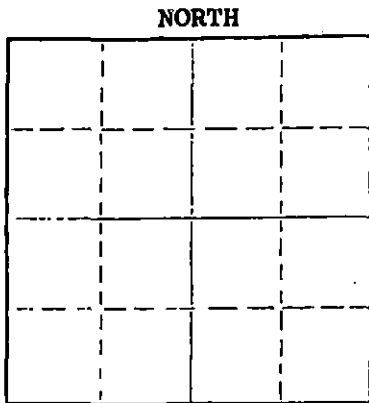

Locate well correctly on above Section Plot

Rice County, Sec. 28 Twp. 20S Rge. 8W (E) (W)
Location as "NE/CNW/SW" or footage from lines C S/2 NW/4
Lease Owner MAPCO, Inc.
Lease Name Smiser Well No. 1
Office Address 1437 South Boulder Avenue, Tulsa, Oklahoma 74119
Character of Well (completed as Oil, Gas or Dry Hole) D & A
Date well completed March 25 1975
Application for plugging filed March 25 1975
Application for plugging approved March 25 1975
Plugging commenced March 25 1975
Plugging completed March 25 1975
Reason for abandonment of well or producing formation D & A

If a producing well is abandoned, date of last production 19
Was permission obtained from the Conservation Division or its agents before plugging was commenced? Yes

Name of Conservation Agent who supervised plugging of this well Mr. Gilbert Toman
Producing formation _____ Depth to top _____ Bottom _____ Total Depth of Well 3382 Feet
Show depth and thickness of all water, oil and gas formations.

OIL, GAS OR WATER RECORDS				CASING RECORD		
FORMATION	CONTENT	FROM	TO	SIZE	PUT IN	PULLED OUT
				8-5/8"	246'	-0-

Describe in detail the manner in which the well was plugged, indicating where the mud fluid was placed and the method or methods used in introducing it into the hole. If cement or other plugs were used, state the character of same and depth placed, from _____ feet to _____ feet for each plug set.

Mud to 500', spot 40 sx. cmt.
Mud to 250', spot 25 sx. cmt.
Mud to 40', 1/2 sk. hulls & plug w/10 sx. cmt.

RECEIVED
STATE CORPORATION COMMISSION
APR 7 1975
CONSERVATION DIVISION
Wichita, Kansas

4-7-75

(If additional description is necessary, use BACK of this sheet)
Name of Plugging Contractor Red Tiger Drilling Company
Address 1720 Wichita Plaza, Wichita, Kansas 67202


STATE OF Kansas COUNTY OF Sedgwick ss.
Linda H. Dickens (employee of owner) or (owner or operator) of the above-described well, being first duly sworn on oath, says: That I have knowledge of the facts, statements, and matters herein contained and the log of the above-described well as filed and that the same are true and correct. So help me God.

(Signature) Linda H. Dickens
1720 Wichita Plaza, Wichita, Kansas 67202
(Address)

SUBSCRIBED AND SWORN to before me this 27th day of March, 1975

My commission expires December 28, 1977

D'Ann Drennan
Notary Public.

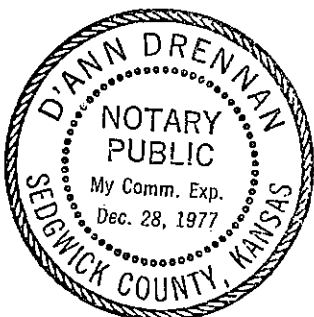

DRILLERS LOG

No. 1 Smiser

CASING RECORD:	COMPANY:	MAPCO, Inc.	DESCRIPTION:
8-5/8" @ 246' w/225' sx. cmt.	CONTRACTOR:	Red Tiger Drilling Co.	C S/2 NW/4. 28-20S-8W Rice County, Kansas
	COMMENCED:	3-17-75	
	COMPLETED:	3-25-75	
TOTAL DEPTH: 3382'			ELEVATION: 1666' K.B.

<u>FORMATION</u>	<u>FROM</u>	<u>TO</u>	<u>REMARKS</u>
Sand & Clay	0	130	
Redbed & Shale	130	230	
Anhydrite	230	252	
Redbed & Shale	252	335	
Shale	335	960	
Lime, Shale & Sand	960	1250	
Shale & Lime	1250	1350	
Lime & Shale	1350	1435	
Flint & Shale	1435	1569	
Lime & Shale	1569	1765	
Shale & Lime	1765	2210	
Lime	2210	2425	
Lime & Shale	2425	2540	
Lime	2540	2756	
Shale	2756	2760	
Lime	2760	2770	
Lime & Shale	2770	2940	
Lime	2940	3348	
Arbuckle	3348	3382	

RECEIVED
STATE CORPORATION COMMISSION
APR 7 1975
CONSERVATION DIVISION
Wichita, Kansas

I certify that this is a true and correct copy of the above log to the best of my knowledge.

RED TIGER DRILLING COMPANY

Linda H. Dickens
Linda H. Dickens

Subscribed and sworn to before me this 27th day of March, 1975.

D. Ann Drennon
Notary Public

My Commission Expires:

December 28, 1977

