


WELL PLUGGING RECORD

STATE OF KANSAS STATE CORPORATION COMMISSION Give All Information Make Required Affidavits Mail or Deliver Reports to: Conservation Division State Corporation Commission 212 No. Market Wichita, Kansas

Rice County. Sec 28 Twp. 20S Rge. 8W (W)

Location as "NE/CNW/SW" or footage from lines SW SW NE Lease Owner: Lebsack Oil Production, Inc. Lease Name: Johnson "B" Well No. 1 Office Address: Box 489, Hays, Kansas 67601 Character of Well (completed as Oil, Gas or Dry Hole) Dry Hole Date well completed April 29 19 68 Application for plugging filed April 29 19 68 Application for plugging approved April 29 19 68 Plugging commenced April 29 19 68 Plugging completed April 29 19 68 Reason for abandonment of well or producing formation Dry Hole

NORTH

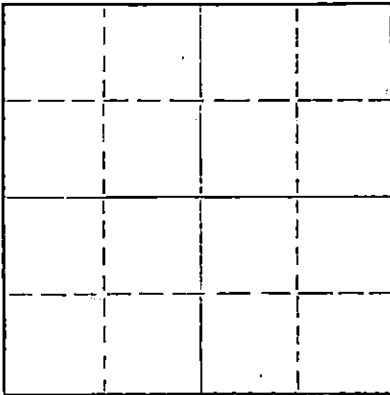

Locate well correctly on above Section Plat

If a producing well is abandoned, date of last production 19 Was permission obtained from the Conservation Division or its agents before plugging was commenced? yes

Name of Conservation Agent who supervised plugging of this well Gilbert Toman Producing formation Depth to top Bottom Total Depth of Well 3410' Feet Show depth and thickness of all water, oil and gas formations.

OIL, GAS OR WATER RECORDS

CASING RECORD

Table with 7 columns: FORMATION, CONTENT, FROM, TO, SIZE, PUT IN, PULLED OUT. Row 1: 223' Red Bed, 145 - 235, 8 5/8, 231', NONE

Describe in detail the manner in which the well was plugged, indicating where the mud fluid was placed and the method or methods used in introducing it into the hole. If cement or other plugs were used, state the character of same and depth placed, from feet to feet for each plug set.

Filled hole with mud to 225' 1/2 sack hulls, plug and 25 sacks cement. Fill hole to 40' 1/2 sack hulls, plug and 10 sacks cement. Two sacks in Rat Hole.

RECEIVED STATE CORPORATION COMMISSION MAY 3 1968 CONSERVATION DIVISION Wichita, Kansas

(If additional description is necessary, use BACK of this sheet)

Name of Plugging Contractor: ISERN DRILLING COMPANY Address: Box 486, Ellinwood, Kansas 67526

STATE OF KANSAS COUNTY OF BARTON ss. W. F. Banks (employee of owner) or (owner or operator) of the above-described well, being first duly sworn on oath, says: That I have knowledge of the facts, statements, and matters herein contained and the log of the above-described well as filed and that the same are true and correct. So help me God.

(Signature) W. F. Banks Box 486, Ellinwood, Kansas 67526 (Address)

SUBSCRIBED AND SWORN to before me this 30th day of April 1968

My commission expires February 20, 1971 George A. Meyer Notary Public

W E L L L O G

RECEIVED
STATE CORPORATION COMMISSION
MAY 3 1968
CONSERVATION DIVISION
Wichita, Kansas

LEBSACK OIL PRODUCTION, INC.
JOHNSON "B" #1, SW SW NE
Section 28-20S-8W
Rice County, Kansas

ELEVATION: 1661' GL; 1663' DF; 1665' KB.

Figures indicate bottom of formation:

PIPE RECORD:

8 5/8" set @ 231'
with 225 sacks cement.

ROTARY COMMENCED: 4-22-68

ROTARY COMPLETED: 4-29-68

TOPS

Anhydrite (drillers) 213
Heebner 2708
Brown Lime 2847
Lansing 2871
Kinderhook Sand 3239
Maquoketa 3266
Viola 3297
Simpson Shale 3328
Simpson Dolomite 3333
Simpson Sand 3353
Arbuckle 3395

0	to	40	surface soil & sand
		145	shale & shells
		213	red bed
		1214	shale & shells
		1600	lime & shale
		2225	shale & shells
		2410	shale & lime
		2475	lime & shale
		2630	shale & lime
		2740	lime & shale
		2845	shale & lime
		3050	lime & shale
		3135	lime
		3410	lime & shale
		3410	Rotary Total Depth
			Dry & Abandoned

STATE OF KANSAS)
COUNTY OF BARTON) ss

I, W. F. Banks, Drilling Superintendent of Isera Drilling Company, contractor for the above-described well being first duly sworn on oath, declare: That I have knowledge of the facts, statements and matter herein contained pertaining to the log of the above-described well, as filed, and that the same are true and correct.


W. F. Banks

Subscribed and sworn to before me on this 2nd day of May, 1968.


George A. Meyer, Notary Public

My commission expires: 2-10-71.