

WELL PLUGGING RECORD

STATE OF KANSAS
STATE CORPORATION COMMISSION


Give All Information Completely
Make Required Affidavit
Mail or Deliver Part to:
Conservation Division
State Corporation Commission
800 Bitting Building
Wichita, Kansas

FORMATION PLUGGING RECORD

Strike out upper line
when reporting plug-
ging off formations.

Rice County. Sec. 28 Twp. 20S Rge. (E) 8 (W)

Location as "NE1/4NW1/4SW1/4" or footage from lines NE NE NE
Lease Owner Alpine Oil & Royalty Co., Inc.
Lease Name Johnson Well No. 1
Office Address Bitting Building, Wichita, Kansas
Character of Well (completed as Oil, Gas or Dry Hole) Dry Hole
Date well completed December 21, 19 48
Application for plugging filed December 21, 19 48
Application for plugging approved December 21, 19 48
Plugging commenced December 21, 19 48
Plugging completed December 21, 19 48
Reason for abandonment of well or producing formation Dry Hole

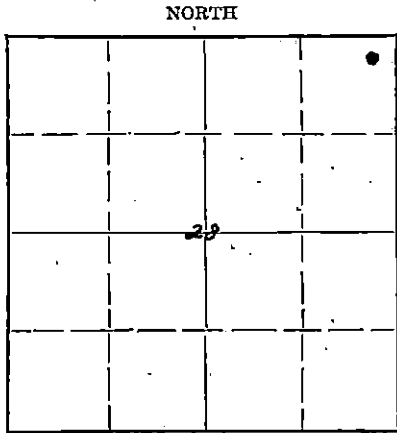

Locate well correctly on above
Section Plat

If a producing well is abandoned, date of last production 19
Was permission obtained from the Conservation Division or its agents before plugging was com-
menced? Yes

Name of Conservation Agent who supervised plugging of this well Ruel Durkee
Producing formation Depth to top Bottom Total Depth of Well 3505 Feet
Show depth and thickness of all water, oil and gas formations.

OIL, GAS OR WATER RECORDS

CASING RECORD

Formation	Content	From	To	Size	Put In	Pulled Out
				8-5/8"	2191	

Describe in detail the manner in which the well was plugged, indicating where the mud fluid was placed and the method or methods used in introducing it into the hole. If cement or other plugs were used, state the character of same and depth placed, from feet to feet for each plug set.

Mudded hole to 200'. Ran 15 sacks cement at 200' through
drill pipe. Mudded to 15' below surface. Ran 5 sacks cement.

(If additional description is necessary, use BACK of this sheet)
Correspondence regarding this well should be addressed to Alpine Oil & Royalty Co., Inc.
Address Bitting Building, Wichita, Kansas

STATE OF Kansas, COUNTY OF Rice, ss.
Rollin Mead (employee of owner) or (owner or operator) of the above-described well,

being first duly sworn on oath, says: That I have knowledge of the facts, statements, and matters herein contained and the log of the above-described well as filed and that the same are true and correct. So help me God.

(Signature) Rollin Mead 1-3-49

Sterling, Kansas
(Address)

SUBSCRIBED AND SWORN TO before me this 28th day of December 19 48.

My commission expires August 17, 1949

22-2625 2-18-15M
PLUGGING
FILE SEC 28 T 20 R 8W
BOOK PAGE 76 LINE 10
JAN 8 1949
Notary Public

Location - N. W. of Section 26-20s-5., Rice County, Kansas.

Owner - Alpine Oil & Royalty Company, Inc., Hitting Building, Wichita, Kansas.
Contractor - Sterling Drilling Company, Sterling, Kansas.

Commenced - 12-5-48
Completed - 12-21-48 (plugged & abandoned)

Total Depth - 3505'

LOG

CASE RECORD

0- 175 Sand, Surface
 175- 250 Sand, Shale & Shells
 250- 725 Shale and Shells
 725-1010 Salt and Shale
 725-1010 Salt and Shale
 1010-1050 Shale and Shells
 1050-2050 Shale and Lime
 2050-2190 Shale and Shells
 2190-2595 Shale and Lime
 2595-3270 Lime
 3270-3295 Shale
 3295-3300 Sand
 3300-3335 Shale and Cherty Lime
 3335-3382 Shale
 3382-3387 Sand
 3387-3430 Lime
 3430-3445 Shale and Sand
 3445-3495 Arbuckle Lime
 3495-3505 Arbuckle

249' 2-5/8" Surface Pipe
Cemented with 250 Sacks Cement.

Took Drill Stem Test @ 3387'
Took Drill Stem Test @ 3432'

PRODUCTION

None. Dry and Abandoned.

RECORDED

JAN 1 1949
ST. JOHNSON
COMMISSION
KANSAS

PLUGGING
FILE SEC. 26 T. 20 R. 8W
BOOK PAGE 76 LINE 10

FILED

ST. JOHNSON