

STATE OF KANSAS
STATE CORPORATION COMMISSION

WELL PLUGGING RECORD


REC'D APR 9 1957

Give All Information Completely
Make Required Affidavit
Mail or Deliver Report to:
Conservation Division
State Corporation Commission
211 No. Broadway
Wichita, Kansas

Rice County. Sec. 28 Twp. 20S Rge. 8W (E) (W)

Location as "NE/CNW/SW" or footage from lines SE SW
Lease Owner Brunson Drilling Co., Inc.
Lease Name Graham Well No. 1
Office Address 333 First Nat'l. Bank - Wichita, Kansas
Character of Well (completed as Oil, Gas or Dry Hole) Gas Well
Date well completed April 26 19 50
Application for plugging filed March 19 19 57
Application for plugging approved March 20 19 57
Plugging commenced March 23 19 57
Plugging completed March 27 19 57
Reason for abandonment of well or producing formation Depleted.

T 20S NORTH R 8W

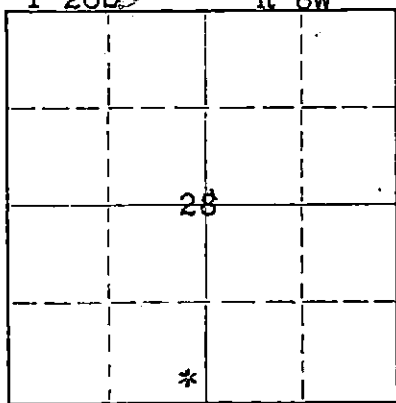

Locate well correctly on above Section Flat

If a producing well is abandoned, date of last production 19

Was permission obtained from the Conservation Division or its agents before plugging was commenced? Yes

Name of Conservation Agent who supervised plugging of this well Ruel Durkee

Producing formation Depth to top Bottom Total Depth of Well 3466 Feet

Show depth and thickness of all water, oil and gas formations.

OIL, GAS OR WATER RECORDS

CASING RECORD

FORMATION	CONTENT	FROM	TO	SIZE	PUT IN	PULLED OUT
				8-5/8"	185'	None
				5-1/2"	3466'	2597'
				Lane Wells plug set at 3325'. Casing perforated from 3308' to 3315'.		

Describe in detail the manner in which the well was plugged, indicating where the mud fluid was placed and the method or methods used in introducing it into the hole. If cement or other plugs were used, state the character of same and depth placed, from feet to feet for each plug set.

Filled the hole with sand from 3325' to 3300' and ran 6 sacks of cement. Mudded the hole to 175', set a 10' rock bridge and ran 15 sacks of cement which filled to 120'. Mudded the hole to 25', set a 5' rock bridge and ran 5 sacks of cement to the base of the cellar. Plugging comp.

(If additional description is necessary, use BACK of this sheet)

Name of Plugging Contractor West Supply Co., Inc.
Address Chase, Kansas

STATE OF KANSAS, COUNTY OF SEDGWICK, ss.
Ralph B. McLaughlin (employee of owner or operator) of the above-described

well, being first duly sworn on oath, says: That I have knowledge of the facts, statements, and matters herein contained and the log of the above-described well as filed and that the same are true and correct. So help me God.

(Signature) Ralph B. McLaughlin
333 First National Bank Bldg.
(Address)

SUBSCRIBED AND SWORN to before me this 9th day of April, 19 57

Wanda Lou Bruce
Wanda Lou Bruce Notary Public.

My commission expires March 6, 1961

PLUGGING
FILE SEC 28 T 20 R 8W
BOOK PAGE 149 LINE 15

APR 10 1957
CONSERVATION DIVISION
Wichita, Kansas

BRUNSON DRILLING COMPANY, INC. et al

Well: Graham #1

SE/4 SW/4 Section 28-20-8
Rice County, Kansas

Commenced Rd: 4/15/50
Completed RD: 4/26/50
Total Depth: 3466'

Elevation: 1668 D.F.
Initial Prod:
Contractor: Brunson Drilling Co.,
Inc.

Casing: 185' 8 3/8" O.D. 24# 8rd thd Casing 140' Cement
3466' 5 1/2" O.D. 14# 8rd thd " 150' Cement

STRATA	DEPTH
Sand	27
Shale & Rock	150
Redbed	225
Anhydrite	245
Redbed & Shale	520
Shale & Shells	900
Salt & Shale	1000
Shale & Shells	1170
Lime	1135
Lime & Shale	1150
Lime	1280
Broken Lime	1465
Shale & Lime	2500
Lime & Shale	2810
Shale & Lime	2915
Lime	2980
Lime & Shale	3045
Lime	3188
Shale	3240
Lime	3293
Sand	3387
Shale	3440
Lime	3466
Total Depth	3466

I hereby certify that the above is a true and correct log of said well as reflected by the daily drilling reports.

BRUNSON DRILLING COMPANY, INC.
By

R. B. McLaughlin
R. B. McLaughlin Asst. Sec.

Signed and sworn to in my presence this 8th day of May, 1950,
by R. B. McLaughlin, asst. secretary of the Brunson Drilling Company,
Inc., a corporation in the State of Kansas.

Edmund C. Cook
Notary Public

My commission expires September 23, 1953.

PLUGGING
FILE SEC 28 20 R 8W
BOOK PAGE 149 LINE 15