


Give All Information Completely
Make Required Affidavit
Mail or Deliver Report to:
Conservation Division
State Corporation Commission
800 Bitting Building
Wichita, Kansas

WELL PLUGGING RECORD

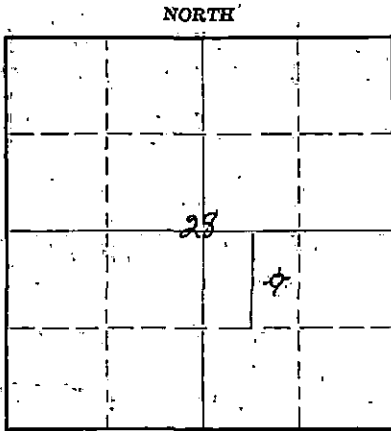

Locate well correctly on above Section Flat

RICE County. Sec. 28 Twp. 20 Rge. (E) 8 (W)
Location as "NE/CNW $\frac{1}{4}$ SW $\frac{1}{4}$ " or footage from lines E/2 NW SE
Lease Owner Thos. H. Allen, et al
Lease Name Hutchins Well No. 1
Office Address 921 Union National Bank Bldg., Wichita 2, Kansas
Character of Well (completed as Oil, Gas or Dry Hole) Dry Hole
Date well completed August 25 19 50
Application for plugging filed August 25 19 50
Application for plugging approved August 25 19 50
Plugging commenced August 25 19 50
Plugging completed August 26 19 50
Reason for abandonment of well or producing formation Dry

If a producing well is abandoned, date of last production _____ 19____
Was permission obtained from the Conservation Division or its agents before plugging was commenced? Yes

Name of Conservation Agent who supervised plugging of this well M. A. Rives
Producing formation Penn. Conglomerate Depth to top 3276 Bottom 3304 Total Depth of Well 3410 Feet
Show depth and thickness of all water, oil and gas formations.

OIL, GAS OR WATER RECORDS

CASING RECORD

Formation	Content	From	To	Size	Put In	Pulled Out
				8 5/8	212'	none
				5 1/2	3278'	2554'

Describe in detail the manner in which the well was plugged, indicating where the mud fluid was placed and the method or methods used in introducing it into the hole. If cement or other plugs were used, state the character of same and depth placed, from _____ feet to _____ feet for each plug set.
3410 - 3270 Rock, Bridge, 5 sacks cement to 3220
3220 - 212 Heavy Mud
212 Wood Plug Bridge and Rock, 15 sacks cement to 150
150 - 30 Heavy Mud
30 - Surface Rock Bridge and 10 sacks cement

RECEIVED

SEP 2 X 1950 9-2-50
STATE CORPORATION
COMMISSION
KANSAS

(If additional description is necessary, use BACK of this sheet)

Correspondence regarding this well should be addressed to Thos. H. Allen
Address 921 Union National Bank Bldg., Wichita 2, Kansas

STATE OF Kansas COUNTY OF Sedgwick ss.
Thos. H. Allan (employer or owner) or (owner or operator) of the above-described well,
being first duly sworn on oath, says: That I have knowledge of the facts, statements, and matters herein contained and the log of the above-described well as filed and that the same are true and correct. So help me God.

(Signature) Thos. H. Allen
921 Union National Bank Bldg., Wichita 2, Kansas
(Address)

SUBSCRIBED AND SWORN to before me this 31st day of August, 1950

Ocie M. Stewart
Notary Public.

My commission expires June 1, 1951

PLUGGING 22-5138-5 9-48-10M
SEC 28 T 20 R 8W
BOOK PAGE 25 LINE 3

8 5/8" @ 212' - 150 sx
5 1/2" @ 3278' - 100 sx - Pulled 2554'

Allan & Brooks #1 Hutchins
E/2 NW SE 28-20-8W
Rice County, Kansas
Comm: 7/21/50 Compl: 8/20/50
Contractor: Tom Allan
Elevation: 1661 R.B.
I.P. D & A

Depth from Rotary Bushings

15-159-03728-0000

0 - 18	Surface Soil & Sand	3118	Shale
148	Sand	3180	Lime & Shale
208	Red beds	3245	Lime with breaks of Gray & Red Shale
228	Anhydrite	3276	Red Shale with Orange Chert
280	Red Shale	3317	Red Mud with Vari Colored Chert
310	Green Shale	3319	Lime
340	Green & Red Shale	3321	Red & Green Shale
370	Gray Shale & Gypsum	3324	Sand
390	Green & red Shale	3328	Red Shale
500	Red Shale & Gypsum	3330	Sand
760	Gray Shale	3338	Lime, Red & Green Shale
790	Red Shale	3350	Sand, Red & Green Shale
1020	Gray Shale & Salt	3369	Red Shale & Weathered Dolomite
1215	Anhydrite	3407	White XLN Lime
1310	Lime	3409	Sandy Lime
1340	Shale	3410	T. D. Red & Green Shale
1390	Cherty Lime		
1440	Shale		
1520	White Sdy Lime & Shale		
1570	Shale		
1650	Lime		
1890	Shale & Shells		
2005	Shale		
2025	Shale & Lime		
2082	Shale		
2100	Lime		
2108	Lime & Sand		
2119	Lime		
2135	Sand & Shale		
2170	Shale & Shells		
2230	Shale		
2400	Shale & Shells		
2410	Sand		
2480	Shale & Shells		
2555	Lime		
2575	Shale		
2660	Lime		
2680	Shale		
2730	Lime		
2740	Shale		
2800	Sand & Shale		
2860	Shale		
2873	Lime, Brown		
2887	Sand & Shale		
2895	Lime, White		
2900	Shale		
2924	Lime		
2957	Lime & Shale		
2974	Lime		
3080	Lime & Shale		
3099	Lime		

FORMATIONS:

204 Top Anhydrite
2860 Top Iatan
2887 Top Lansing
3276 Top Sooy
3369 Top Viola
3409 Top Simpson

I certify that the above is a true and correct copy of the well log on the above test.

Tom Allan

Subscribed and sworn to before me this 1st day of September, 1950.

Oliver M. Stewart

My Commission expires June 14, 1954

