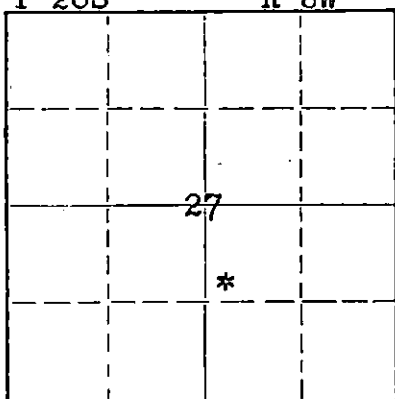


Give All Information Completely  
Make Required AffidavitMail or Deliver Report to:  
Conservation Division  
State Corporation Commission  
211 No. Broadway  
Wichita, Kansas

15.159.00218.0000

## WELL PLUGGING RECORD

T 20S NORTH R 8W

Locate well correctly on above  
Section Plat

Rice

County. Sec. 27 Twp. 20S Rge. 8W (E) (W)

Location as "NE/CNW&amp;SW" or footage from lines

Lease Owner Casebeer &amp; Litan

Lease Name Ray

Well No. 1

Office Address Box 647 - McPherson, Kansas

Character of Well (completed as Oil, Gas or Dry Hole)

Date well completed

19

Application for plugging filed

19

Application for plugging approved

19

Plugging commenced

June 4

19

56

Plugging completed

June 7

19

56

Reason for abandonment of well or producing formation

If a producing well is abandoned, date of last production

19

Was permission obtained from the Conservation Division or its agents before plugging was commenced? Yes

Name of Conservation Agent who supervised plugging of this well

Ruel Durkee

Producing formation

Depth to top

Bottom

Total Depth of Well 3314

Feet

Show depth and thickness of all water, oil and gas formations.

## OIL, GAS OR WATER RECORDS

## CASING RECORD

FORMATION	CONTENT	FROM	TO	SIZE	PUT IN	PULLED OUT
				8-5/8"	203'	None
				5-1/2"	3305'	2901'

Describe in detail the manner in which the well was plugged, indicating where the mud fluid was placed and the method or methods used in introducing it into the hole. If cement or other plugs were used, state the character of same and depth placed, from \_\_\_\_\_ feet to \_\_\_\_\_ feet for each plug set.

Filled the hole with sand from 3314' to 3295' and ran 6 sacks of cement. Mudded the hole to 190', set a 10' rock bridge and ran 15 sacks of cement. Mudded the hole to 30', set a rock bridge and ran 5 sacks of cement on top. Plugging completed.

6-15-56

Name of Plugging Contractor

(If additional description is necessary, use BACK of this sheet)

West Supply Co., Inc.

Address

Chase, Kansas

STATE OF

COUNTY OF

(employee of owner) or (owner or operator) of the above-described

well, being first duly sworn on oath, says: That I have knowledge of the facts, statements, and matters herein contained and the log of the above-described well as filed and that the same are true and correct. So help me God.

(Signature)

(Address)

SUBSCRIBED AND SWORN TO before me this

day of

1956

My commission expires

2-15-58

Notary Public.

## PLUGGING

FILE SEC 27 T 20 R 8W  
BOOK PAGE 70 LINE 18

WELL LOG----- Ray #1

Location - SW/4 NW/4 SE/4 of Section 27-20-8, Rice County, Kansas.

Owners - Herschel Hutchins and G. T. Hutchins  
 Contractor - Sterling, Drilling Company

Commenced - 11-5-50  
 Completed - 11-18-50 (w/r)  
 11-20-50 (w/c.t.)

Total Depth - 3312' (w/r)  
 3314' (w/c.t.)

Elevation: 1657 DF  
 1654 Gr

## Log

0- 90 Clay, sand and gravel  
 90-195 Red bed  
 195-220 Anhydrite  
 220-830 Shale and shells  
 830-975 Salt  
 975-1080 Shale and shells  
 1080-1150 Lime and shale  
 1150-1244 Lime  
 1255-1455 Lime and sand strks  
 1455-1570 lime and shale  
 1570-1830 broken lime  
 1830-1930 shale and lime shells  
 1930-2100 shale and shells  
 2100-2475 shale and lime  
 2475-2580 Lime (broken)  
 2580-2665 Lime and shale  
 2665-2760 lime  
 2760-2870 lime and shale  
 2870-3264 lime  
 3264-3290 shale and lime  
 3290-3307 shale  
 3307-3312 conglomerate  
 3312-3314 conglomerate

## Casing Record

203' of 8 5/8" Surface pipe  
 cemented with 110 sacks  
 cement

3305' of 5 1/2" O.D. Casing  
 cemented w/50 sacks cement  
 (set 7' off bottom)

PRODUCTION: PRODUCER

PLUGGING

FILE SEC 27 T-20 R 8 W  
 BOOK PAGE 70 LINE 18

RECEIVED  
 CONSERVATION DIVISION  
 Wichita, Kansas