


STATE OF KANSAS  
STATE CORPORATION COMMISSION

WELL PLUGGING RECORD

Give All Information Completely  
Make Required Affidavit  
Mail or Deliver Report to:  
Conservation Division  
State Corporation Commission  
300 Bittling Building  
Wichita, Kansas

NORTH

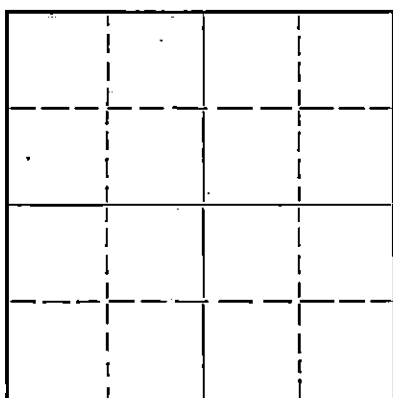

Locate well correctly on above  
Section Flat

Rice County, Sec. 27, Twp. 20, Rge. 8 (E) (W)  
Location as "NE/CNW/SW" or footage from lines SE/4 NW/4 SE/4  
Lease Owner Herschel Hutchins et al  
Lease Name Ray Well No. 2  
Office Address Route 2, Lyons, Kansas  
Character of Well (completed as Oil, Gas or Dry Hole) Dry Hole  
Date well completed January 26 19 51  
Application for plugging filed January 25 19 51  
Application for plugging approved January 25 19 51  
Plugging commenced January 26 19 51  
Plugging completed January 26 19 51  
Reason for abandonment of well or producing formation Dry Hole

If a producing well is abandoned, date of last production \_\_\_\_\_ 19\_\_\_\_  
Was permission obtained from the Conservation Division or its agents before plugging was commenced? Yes

Name of Conservation Agent who supervised plugging of this well Mr. Ruel E. Durkee  
Producing formation \_\_\_\_\_ Depth to top \_\_\_\_\_ Bottom \_\_\_\_\_ Total Depth of Well 3117 Feet  
Show depth and thickness of all water, oil and gas formations.

OIL, GAS OR WATER RECORDS

CASING RECORD

Formation	Content	From	To	Size	Put In	Pulled Out
				8-5/8"	200'	

Describe in detail the manner in which the well was plugged, indicating where the mud fluid was placed and the method or methods used in introducing it into the hole. If cement or other plugs were used, state the character of same and depth placed, from \_\_\_\_\_ feet to \_\_\_\_\_ feet for each plug set.

Gunned the pits and circulated the hole.  
When half way out, circulated again. Set  
bridge at 190'. Ran 15 sacks cement  
through 6 joints of drill pipe. Set plug  
at 30' below cellar. Ran 10 sacks cement.

STATE CORPORATION COMMISSION  
FEB - 1 1951  
CONSERVATION DIVISION  
WICHITA, KANSAS

2-1-51

(If additional description is necessary, use BACK of this sheet)

Correspondence regarding this well should be addressed to Sterling Drilling Company  
Address Sterling, Kansas

STATE OF Kansas, COUNTY OF Rice, ss.  
Rollin Mead (employee of owner) of the above-described well,  
being first duly sworn on oath, says: That I have knowledge of the facts, statements, and matters herein contained and the log of the above-described well as filed and that the same are true and correct. So help me God.

(Signature) *Rollin Mead*  
Sterling, Kansas  
(Address)

SUBSCRIBED AND SWORN to before me this 30th day of January, 19 51

My Commission Expires Sept. 17, 1953

My commission expires \_\_\_\_\_ Notary Public.

PLUGGING  
FILE SEC 27 T 20 R 8W  
BOOK PAGE 59 LINE 16

STERLING DRILLING COMPANY

STERLING, KANSAS

WELL LOG ----- RAY #2

Location - SE/4 NW/4 SE/4 of Section 27-20-0, Rice County, Kansas.

Owner - Herschel Hutchins et al  
 Contractor - Sterling Drilling Company

Commenced - 1-16-51  
 Completed - 1-26-51 (w/r)

Total Depth - 3447' (w/r)

ELEVATION: Est. 1653 DF  
 1650 Gr

LOG

0- 80	Surface Soil & Sand.
80- 195	Red Bed.
195- 210	Anhydrite.
210- 225	Shale
225- 975	Shale, Shells & Salt
975-1440	Shale and Lime
1440-1590	Lime
1590-2680	Lime and Shale
2680-2710	Lime
2710-2990	Lime and Shale
2990-3180	Lime
3180-3235	Lime and Shale
3235-3255	Lime
3255-3308	Shale and Lime
3308-3313	Conglomerate
3313-3350	Shale
3350-3425	Lime
3425-3440	Sandy Shale
3440-3447	Sand

CASING RECORD

200' of 8-5/8" Surface Pipe  
 Cemented with 150 Sacks Cement

**RECEIVED**  
 STATE CORPORATION COMMISSION  
 FEB - 1 1951  
 CONSERVATION DIVISION  
 Wichita, Kansas

**PLUGGING**  
 FILE SEC 27 T 20 R 8W  
 BOOK PAGE 59 LINE 16