


STATE OF KANSAS  
STATE CORPORATION COMMISSION

Form CP-4

WELL PLUGGING RECORD

Give All Information Completely  
Make Required Affidavit  
Mail or Deliver Report to:  
Conservation Division  
State Corporation Commission  
212 No. Market  
Wichita, Kansas

NORTH

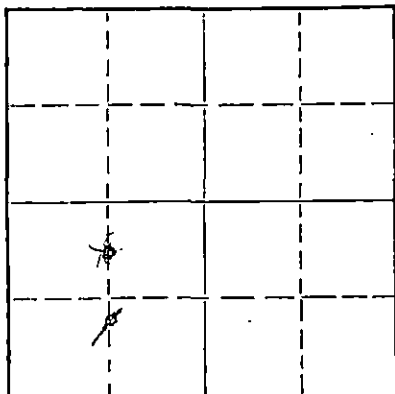

Locate well correctly on above  
Section Plat

Rice County, Sec. 27 Twp. 20 Rge. 8 (E) (W) X  
Location as "NE/CNW/SW" or footage from lines C N/2 S/2 SW  
Lease Owner Thomas H. Allan  
Lease Name Will Edgar Well No. #2  
Office Address 925 Union Center, Wichita, Kansas  
Character of Well (completed as Oil, Gas or Dry Hole)  
Date well completed 19  
Application for plugging filed 19  
Application for plugging approved 19  
Plugging commenced 7-2-66 19  
Plugging completed 7-20-66 19  
Reason for abandonment of well or producing formation

If a producing well is abandoned, date of last production 19  
Was permission obtained from the Conservation Division or its agents before plugging was commenced?

Name of Conservation Agent who supervised plugging of this well Gilbert Toman  
Producing formation Depth to top Bottom Total Depth of Well 3316' Feet  
Show depth and thickness of all water, oil and gas formations.

OIL, GAS OR WATER RECORDS

CASING RECORD

FORMATION	CONTENT	FROM	TO	SIZE	PUT IN	PULLED OUT

Describe in detail the manner in which the well was plugged, indicating where the mud fluid was placed and the method or methods used in introducing it into the hole. If cement or other plugs were used, state the character of same and depth placed, from feet to feet for each plug set.

Made bottom hole plug back with sand to 3280', mixed and ran 5 sacks cement thru dump bailer.  
Mudded hole to 200', set 10' rock bridge. Mixed and ran 20 sacks cement thru dump bailer to base of cellar.

RECEIVED  
STATE CORPORATION COMMISSION

JUL 22 1966

CONSERVATION DIVISION  
WICHITA, KANSAS

(If additional description is necessary, use BACK of this sheet)

Name of Plugging Contractor Southwest Casing Pulling Co., Inc.  
Address Box 364, Great Bend, Kansas

STATE OF Kansas, COUNTY OF Barton, ss.  
Southwest Casing Pulling Co., Inc. (employee of owner) or (owner or operator) of the above-described well, being first duly sworn on oath, says: That I have knowledge of the facts, statements, and matters herein contained and the log of the above-described well as filed and that the same are true and correct. So help me God.

(Signature) W. C. Spencer Sec.  
Box 364, Great Bend, Kansas  
(Address)

SUBSCRIBED AND SWORN TO before me this 21 day of July, 19 66

My commission expires 24 October 1968

Sidney D. Miller  
Notary Public.

8 5/8" @ 208' - 170 ex  
 5 1/2" @ 3297' - 75 ex

ALLAN, et al #2 WILL EDGAR  
 C N/2 S/2 SW 27-20-3W  
 Rice County, Kansas  
 COM: 3/25/52 COMPL: 4/17/52  
 CONTRACTOR: Tom Allan  
 ELEVATION: 1659 DF  
 1661 RB

I.P. Flow 25 BOPD

Depth from Rotary Bushings

0 - 20	Surface Soil & Sand
95	Coarse Gravel
206	Red Beds
219	Anhydrite
790	Red, Green & Gray Shale
1020	Salt & Shale
1210	Anhydrite
1300	Lime
1640	Lime & Shale
1880	Shale & Shells
2080	Shale
2110	Lime
2470	Shale & Shells
2555	Lime
2740	Lime & Shale
2870	Shale
2876	Brown Lime
2897	Sand & Shale
3267	Lime & Shale
3296	Red & Green Shale
3297	RTD Varicolored Chert
3297	RB = 3297 DF SLM
3304	DF Varicolored Chert & Sand (Show Oil & Gas)
3306	DF Varicolored Chert & Red Mud
3317	DF (TD) Red Shale

APR 9 1953  
 COMPLETION DIVISION  
 WICHITA, KANSAS

FORMATIONS:

Top Lancing 2897 RB  
 Top Conglomerate 3296 RB

TESTING:

Swab 7 1/2 BOPD  
 Hydrafrac - Flow 24 1/2 BOPD