


WELL PLUGGING RECORD

Give All Information Completely
Make Required Affidavit
Mail or Deliver Report to:
Conservation Division
State Corporation Commission
800 Biting Building
Wichita, Kansas

NORTH

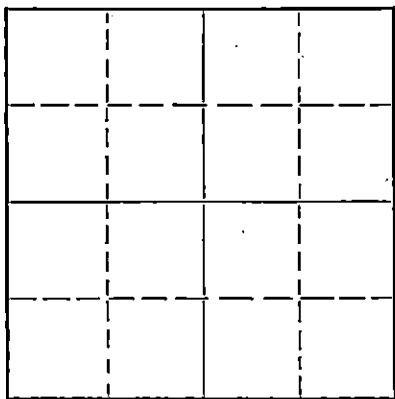

Locate well correctly on above
Section Flat

Rice County. Sec. 27 Twp. 20 Rge. 8 (E) (W)
Location as "NE/CNW $\frac{1}{4}$ SW $\frac{1}{4}$ " or footage from lines SE $\frac{1}{4}$ SW $\frac{1}{4}$ NE $\frac{1}{4}$
Lease Owner Hutchins Brothers (Herschel Hutchins)
Lease Name Ray Well No. 4
Office Address Route #2, Lyons, Kansas
Character of Well (completed as Oil, Gas or Dry Hole) Dry Hole
Date well completed 12-22-51 19 51
Application for plugging filed 12-10- 19 51
Application for plugging approved 12-10- 19 51
Plugging commenced 12-10- 19 51
Plugging completed 12-21- 19 51
Reason for abandonment of well or producing formation Dry Hole

If a producing well is abandoned, date of last production 19
Was permission obtained from the Conservation Division or its agents before plugging was commenced? Yes

Name of Conservation Agent who supervised plugging of this well Ruel E. Durkee
Producing formation Depth to top Bottom Total Depth of Well 3327 Feet
Show depth and thickness of all water, oil and gas formations.

OIL, GAS OR WATER RECORDS

CASING RECORD

Formation	Content	From	To	Size	Put In	Pulled Out
				8-5/8"	99'	
				5 1/2"	3312'	2916'

Describe in detail the manner in which the well was plugged, indicating where the mud fluid was placed and the method or methods used in introducing it into the hole. If cement or other plugs were used, state the character of same and depth placed, from feet to feet for each plug set.

Plugged back to 3300'. Dumped 6 sacks cement.
Pulled pipe and mudded hole. Set bridge at
150' and put in 20 sacks cement. 5 sacks cement
at top.

1-2-52
STATE OF KANSAS
CONSERVATION DIVISION
WICHITA, KANSAS

(If additional description is necessary, use BACK of this sheet)
Correspondence regarding this well should be addressed to Sterling Drilling Company
Address Sterling, Kansas


STATE OF Kansas, COUNTY OF Rice, ss.
Rollin Mead (employee of owner) or (owner or operator) of the above-described well,
being first duly sworn on oath, says: That I have knowledge of the facts, statements, and matters herein contained and the log of the above-described well as filed and that the same are true and correct. So help me God.

(Signature) *Rollin Mead*
Sterling, Kansas
(Address)

SUBSCRIBED AND SWORN to before me this 28th day of December, 19 51

My Commission Expires Sept. 17, 1953

My commission expires _____ Notary Public.

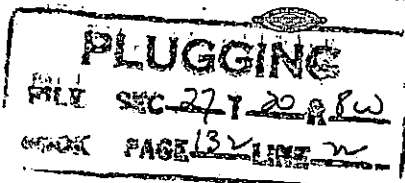

STERLING DRILLING CO.

STERLING, KANSAS

WELL LOG ----- RAY #4

Location - SE/4 SW/4 NE/4 Section 27-20-8, Rice County, Kansas

Owner - Hutchins Brothers (Herschel Hutchins et al)
 Rotary Drilling Contractor - Sterling Drilling Company
 Cable Tools Contractor - Sterling Drilling Company

Commenced - 11-9-51
 Completed - 11-20-51 (w/r)
 - 12-22-51 (w/c.t.)

Total Depth - 3307' (w/r)
 - 3327' (w/c.t.)

ELEVATION: 1658 DF
 1655 Gr

LOG

0- 99	Sand and Clay
99- 375	Sand, Red Bed and Shells
375- 850	Shale
850-1120	Shale and Shells
1120-2005	Shale and Lime
2005-2225	Shale and Shells
2225-2465	Shale and Lime
2465-2635	Lime
2635-2875	Lime and Shale
2875-3275	Lime
3275-3304	Shale
3304-3307	Conglomerate


CASING RECORD

99' of 8-5/8" Surface Pipe
 Cemented with 75 Sacks Cement
 (1' off bottom)

3312' of 5 1/2" O. D. Casing
 Cemented with 50 Sacks Cement
 (1 1/2' off bottom)

PRODUCTION: Dry and Abandoned

CABLE TOOLS RECORD: Cleaned out to rotary total depth of 3307', with no show of any kind. Drilled to 3327', with no shows. Perforated with Lane-Wells cone shots from 3303-3316 1/2. After 8 hours, hole had approximately 1 gal. of free oil. Plugged the bottom and pulled pipe.

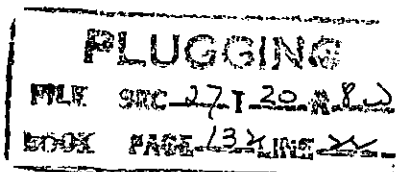

RECEIVED
 STATE CORPORATION COMMISSION
 JAN - 2 1952
 CONSERVATION DIVISION
 Wichita, Kansas