


STATE OF KANSAS
STATE CORPORATION COMMISSION

Give All Information Completely
Make Required Affidavit
Mail or Deliver Report to:
Conservation Division
State Corporation Commission
211 No. Broadway
Wichita, Kansas

WELL PLUGGING RECORD

Rice County, Sec. 27 Twp. 20 Rge. 8 (W)
Location as "NE/CNW%SW%" or footage from lines NE SE SW
Lease Owner Thos. H. Allan, et al
Lease Name Will Edgar Well No. 1
Office Address 925 Union Center, Wichita 2, Kansas
Character of Well (completed as Oil, Gas or Dry Hole) Oil Well
Date well completed May 15 19 51
Application for plugging filed September 27 19 56
Application for plugging approved September 27 19 56
Plugging commenced October 2 19 56
Plugging completed October 9 19 56
Reason for abandonment of well or producing formation Bar Depleted

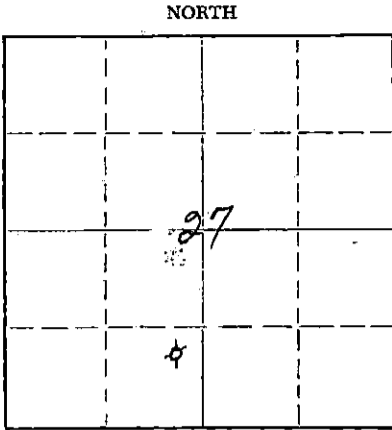

Locate well correctly on above
Section Plat

If a producing well is abandoned, date of last production June 19 56
Was permission obtained from the Conservation Division or its agents before plugging was commenced? Yes

Name of Conservation Agent who supervised plugging of this well Ruel Durkee
Producing formation Cherty Conglomerate Depth to top 3302 Bottom --- Total Depth of Well 3315 Feet
Show depth and thickness of all water, oil and gas formations.

OIL, GAS OR WATER RECORDS

CASING RECORD

FORMATION	CONTENT	FROM	TO	SIZE	PUT IN	PULLED OUT
				8 5/8"	205'	none
				5 1/2"	3303'	2383'

Describe in detail the manner in which the well was plugged, indicating where the mud fluid was placed and the method or methods used in introducing it into the hole. If cement or other plugs were used, state the character of same and depth placed, from _____ feet to _____ feet for each plug set.

- 3315 - 3295 Crushed Rock
- 3295 - 3255 6 sacks of cement
- 3255 - 165 Mud
- 165 - 120 Rock Bridge and 15 sacks of cement
- 120 - 20 Mud
- 20 - Surface Rock Bridge and 5 sacks of cement

(If additional description is necessary, use BACK of this sheet)

Name of Plugging Contractor Miller Casing Pulling Company
Address Great Bend, Kansas

STATE OF KANSAS, COUNTY OF SEDGWICK, ss.
Thos. H. Allan (Employee or owner) or (owner or operator) of the above-described well, being first duly sworn on oath, says: That I have knowledge of the facts, statements, and matters herein contained and the log of the above-described well as filed and that the same are true and correct. So help me God.

(Signature) Thos. H. Allan
925 Union Center, Wichita 2, Kansas
(Address)

SUBSCRIBED AND SWORN TO before me this 15th day of October, 19 56

My commission expires June 14, 1958

Ocie M. Stewart
RECEIVED
STATE CORPORATION COMMISSION
Notary Public.

PLUGGING
FILE SEC 27 T. 20 R. 8W
BOOK PAGE 103 LINE 16

OCT 16 1956
CONSERVATION DIVISION
Wichita, Kansas

S 5/8" @ 205' - 175oz

S 1/2" @ 3303' - 75oz

ALLAN et al. #1 Will Edgar
NE SE 3/4 27-20-91
Rice County, Kansas
Comm: 1/25/51 Compl: 5/15/51
Contractor: Tom Allan
Elevation: 1661 RB
IP: Swab 16 BOPD

Depth from Rotary Bushings

- 0 - 35 Surface Soil
- 120 Sand & Gravel
- 203 Red Beds
- 245 Anhydrite
- 360 Red & Green Shale
- 370 Gray Shale & Anhydrite
- 500 Red & Green Shale
- 760 Gray Shale
- 790 Red Shale
- 1020 Gray Shale & Salt
- 1220 Anhydrite
- 1310 Lime
- 1340 Shale
- 1390 Cherty Lime
- 1440 Shale
- 1520 Lime & Shale
- 1570 Shale
- 1650 Lime
- 1890 Shale & Shells
- 2010 Shale
- 2025 Shale & Lime
- 2090 Shale
- 2120 Lime
- 2140 Sand & Shale
- 2170 Shale & Shells
- 2240 Shale
- 2410 Shale & Shells
- 2420 Sand
- 2480 Shale & Shells
- 2565 Lime
- 2585 Shale
- 2670 Lime
- 2690 Shale
- 2750 Lime & Shale
- 2805 Sand & Shale
- 2885 Shale & Shells
- 2905 Shale & Sand
- 3270 Lime & Shale
- 3300 Red & Green Shale &
Orange Chert
- 3304 Red Mud & Varicolored
Chert
- Rotary 3304 Cable Tools 3302
- 3306 Red & Green Sandy Shale
- 3311 Varicolored Chert
- 3315 (TD) Red, Green & Gray Shale

FORMATIONS: Rotary Bushing Measurements

- Anhydrite 204
- Brown Lime 7877
- Lansing 2905
- Cherty Conglomerate 3302

TESTING:

- Good Show Oil 3306 - 11
- Shot 14, Open Hole Kershats (No Help)
- Swab 16 BOPD

RECEIVED
STATE CORPORATION COMMISSION
OCT 9 1956
CONSERVATION DIVISION
Wichita, Kansas

PLUGGING
FILE: SEC 27 T 20 R 8 W
BOOK: PAGE 103 LINE 16