

STATE OF KANSAS  
STATE CORPORATION COMMISSION

Form CP-4

Give All Information Completely  
Make Required Affidavit  
Mail or Deliver Report to:  
Conservation Division  
State Corporation Commission  
212 No. Market  
Wichita, Kansas 67202

WELL PLUGGING RECORD

Rice County, Sec. 23 Twp. 20 Rge. 10 (E) (W)

Location as "NE/CNWSW" or footage from lines NW NW NE

Lease Owner Knight Casing Pulling Co., Inc.

Lease Name Proffitt #1 Well No.

Office Address Chase, Kansas 67524

Character of Well (completed as Oil, Gas or Dry Hole)

Date well completed 19

Application for plugging filed 19

Application for plugging approved 19


Plugging commenced 4/8/70 19

Plugging completed 4/9/70 19

Reason for abandonment of well or producing formation depleted.

If a producing well is abandoned, date of last production 19

Was permission obtained from the Conservation Division or its agents before plugging was commenced? yes

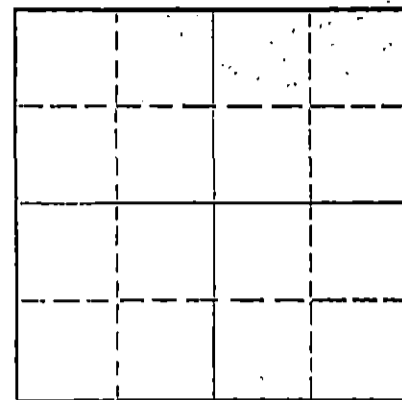

Locate well correctly on above Section Plot

Name of Conservation Agent who supervised plugging of this well Toman

Producing formation Depth to top Bottom Total Depth of Well 2410 Feet

Show depth and thickness of all water, oil and gas formations.

OIL, GAS OR WATER RECORDS

CASING RECORD

FORMATION	CONTENT	FROM	TO	SIZE	PUT IN	PULLED OUT
	RECEIVED			8-5/8	186	none
	STATE CORPORATION COMMISSION			4 1/2	2410	1883
	APR 13 1970					
	CONSERVATION DIVISION					
	Wichita, Kansas					

Describe in detail the manner in which the well was plugged, indicating where the mud fluid was placed and the method or methods used in introducing it into the hole. If cement or other plugs were used, state the character of same and depth placed, from feet to feet for each plug set.

Sanded hole to 2300', ran 3 sacks of cement. Rigged up, shot pipe at 2142', 2050', 1882', pulled 60 joints. Plugged well, rock bridge 190 to 180', 25 sacks of cement. Mudded to 40', 10' rock bridge, Mud to 30' and ran 10 sacks of cement. Plugging complete.

(If additional description is necessary, use BACK of this sheet)

Name of Plugging Contractor KNIGHT CASING PULLING CO., INC.

Address CHASE, KANSAS

STATE OF KANSAS, COUNTY OF RICE, ss.


NOEL J. KNIGHT (employee of owner) or (owner or operator) of the above-described well, being first duly sworn on oath, says: That I have knowledge of the facts, statements, and matters herein contained and the log of the above-described well as filed and that the same are true and correct. So help me God.

(Signature) Noel Knight

CHASE, KANSAS

(Address)

Subscribed and Sworn to before me this 9th day of April 19 70

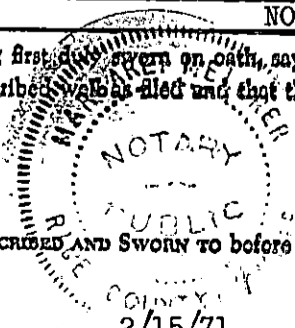

Margaret Melcher

Notary Public.

My commission expires 2/15/71