

STATE OF KANSAS
STATE CORPORATION COMMISSION

Form CP-4

Give All Information Completely
Make Required Affidavit
Mail or Deliver Report to:
Conservation Division
State Corporation Commission
212 No. Market
Wichita, Kansas

WELL PLUGGING RECORD

Rice County, Sec. 23 Twp. 20 Rge. (E) 10 (W)

Location as "NE/CNW/SW" or footage from lines SW NW SE

Lease Owner Woodman & Iannitti Drilling Co.

Lease Name Scott Well No. 1

Office Address 706 Union Nat'l. Bldg.

Character of Well (completed as Oil, Gas or Dry Hole) Dry Hole

Date well completed May 2 1967

Application for plugging filed May 2 1967

Application for plugging approved May 2 1967


Plugging commenced May 2 1967

Plugging completed May 2 1967

Reason for abandonment of well or producing formation Dry

If a producing well is abandoned, date of last production 19

Was permission obtained from the Conservation Division or its agents before plugging was commenced? Yes

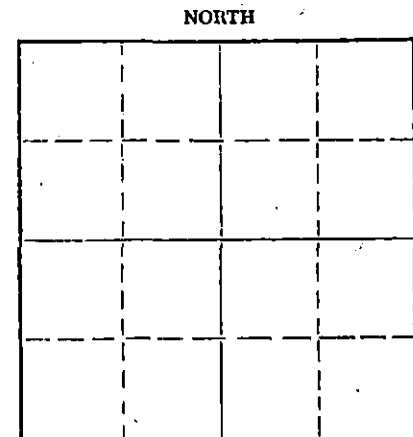

Locate well correctly on above Section Plat

Name of Conservation Agent who supervised plugging of this well Gilbert Toman

Producing formation Depth to top Bottom Total Depth of Well 3400 Feet

Show depth and thickness of all water, oil and gas formations.

OIL, GAS OR WATER RECORDS

CASING RECORD

FORMATION	CONTENT	FROM	TO	SIZE	PUT IN	PULLED OUT
				8 5/8	190'	

Describe in detail the manner in which the well was plugged, indicating where the mud fluid was placed and the method or methods used in introducing it into the hole. If cement or other plugs were used, state the character of same and depth placed, from feet to feet for each plug set.

Bottom Plug @ 180' w/25 sx
Top Plug @ 40' w/10 sx

RECEIVED
STATE CORPORATION COMMISSION
MAY 8 1967
CONSERVATION DIVISION
Wichita, Kansas

(If additional description is necessary, use BACK of this sheet)

Name of Plugging Contractor Woodman & Iannitti Drilling Co.

Address 706 Union Nat'l. Bldg.

STATE OF Kansas, COUNTY OF Sedgwick, ss.

K. T. Woodman (employee of owner) or (owner or operator) of the above-described well, being first duly sworn on oath, says: That I have knowledge of the facts, statements, and matters herein contained and the log of the above-described well as filed and that the same are true and correct. So help me God.

(Signature) K. T. Woodman

706 Union Nat'l. Bldg. (Address)

SUBSCRIBED AND SWORN TO before me this 5th day of May, 1967

My commission expires Feb. 11, 1968

Justina Chamberlain
Justina Chamberlain Notary Public.

KANSAS GEOLOGICAL SOCIETY
KANSAS WELL LOG BUREAU - KANSAS WELL SAMPLE BUREAU
KANSAS GEOLOGICAL SOCIETY BUILDING
508 EAST MURDOCK - WICHITA, KANSAS

COMPANY Woodman & Iannitti Drilling Co.

SEC. 23 T. 20 R. 10W
LOC. SW NW SE

FARM Scott NO. 1

COUNTY Rice


TOTAL DEPTH 3400
COMM. April 26, 1967 COMP. May 2, 1967

KANSAS

SHOT OR TREATED

CONTRACTOR Woodman & Iannitti Drilling Co.

ISSUED

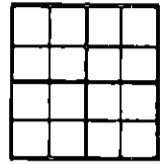

CASING

20 10
15 5/8 @ 190'
12 6
13 5

ELEVATION 1807 K.B.

PRODUCTION D & A

FIGURES INDICATE BOTTOM OF FORMATIONS

130 Clay & Rock
192 Blue & Shale
240 Red Bed & Shale
445 Red Bed
470 Anhy
1275 Shale
1560 Lime
1780 Lime
1955 Lime
2265 Lime & Shale
2615 Shale & Lime
2732 Lime
2840 Lime
2935 Lime
3030 Lime
3115 Lime
3205 Lime
3277 Lime
3350 Lime
3378 Lime
3400 Lime

RECEIVED
STATE CORPORATION COMMISSION
MAY 8 1967
CONSERVATION DIVISION
Wichita, Kansas

I certify the above to be a true and correct copy of the driller's log and the geological tops to the best of my knowledge and belief.

Woodman & Iannitti Drilling Co.

K. T. Woodman
K. T. Woodman