


STATE OF KANSAS
STATE CORPORATION COMMISSION
CONSERVATION DIVISION
P. O. BOX 17027
WICHITA, KANSAS 67217

WELL PLUGGING RECORD

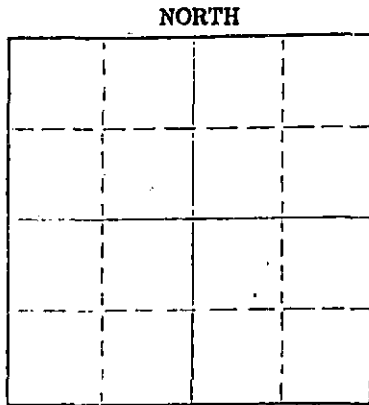

Locate well correctly on above Section Plat

Rice County. Sec. 36 Twp. 20S Rge. 10W (EX) (W)
Location as "NE/CNW&SW" or footage from lines C NW SW
Lease Owner Lebsack Oil Production, Inc.
Lease Name Eatinger #1 Well No. 1
Office Address P. O. Box 489, Hays, Kansas 67601
Character of Well (completed as Oil, Gas or Dry Hole) Dry Hole
Date well completed March 24, 1976 19
Application for plugging filed March 23, 1976 19
Application for plugging approved March 23, 1976 19
Plugging commenced 1:00 AM, March 24, 1976 19
Plugging completed 2:00 AM, March 24, 1976 19
Reason for abandonment of well or producing formation Dry Hole

If a producing well is abandoned, date of last production 19
Was permission obtained from the Conservation Division or its agents before plugging was commenced? Yes

Name of Conservation Agent who supervised plugging of this well Gilbert Toman
Producing formation _____ Depth to top _____ Bottom _____ Total Depth of Well _____ Feet
Show depth and thickness of all water, oil and gas formations.

OIL, GAS OR WATER RECORDS				CASING RECORD		
FORMATION	CONTENT	FROM	TO	SIZE	PUT IN	PULLED OUT
				7"	276.47'	None

Describe in detail the manner in which the well was plugged, indicating where the mud fluid was placed and the method or methods used in introducing it into the hole. If cement or other plugs were used, state the character of same and depth placed, from _____ feet to _____ feet for each plug set.

Filled hole with heavy mud.
40 sacks Pozmix "A" cement at 150'
25 sacks cement at 200'; ~~XXXXXXXXXXXXXXX~~
1/2 sack hulls and plug, mud up to 40',
10 sacks cement.

RECEIVED
STATE CORPORATION COMMISSION

MAR 31 1976

3-30-76

Name of Plugging Contractor Sterling Drilling Company
Address P. O. Box 129, Sterling, Kansas 67579
(If additional description is necessary, use BACK of this sheet)
CONSERVATION DIVISION
WICHITA, KANSAS

STATE OF KANSAS COUNTY OF RICE, ss.
F. A. Wuellner, (employee of owner) or (owner or operator) of the above-described

well, being first duly sworn on oath, says: That I have knowledge of the facts, statements, and matters herein contained and the log of the above-described well as filed and that the same are true and correct. So help me God. STERLING DRILLING COMPANY

(Signature) F. A. Wuellner, Secretary
P. O. Box 129, Sterling, Kansas 67579
(Address)

Subscribed and sworn to before me this 26th day of March, 1976.

CHARLES HALL—NOTARY PUBLIC
My Commission Expires Jan. 6, 1978

Charles M. Hall, Notary Public.



STERLING DRILLING COMPANY
P. O. Box 129
Sterling, Kansas 67579

WELL LOG ----- EATINGER #1

Located: C NW SW, Section 36-20S-10W, Rice County, Kansas

OWNER: Lebsack Oil Production, Inc. and Piper Petroleum Company

ROTARY DRILLING CONTRACTOR: Sterling Drilling Company

COMMENCED: March 15, 1976

COMPLETED: March 24, 1976

TOTAL DEPTH: 2260'

<u>LOG</u>		<u>CASING RECORD</u>
0 - 65	Gravel and Sand	Ran 7 joints used 7", 20#, OD casing, 216.41' set at 215' G.L. with 125 sacks 60/40 Pozmix with 2% gel and 2% cc. Plug down at 5:15 PM, 3-15-76.
65 - 225	Red Bed	
225 - 660	Bed Bed, Shale with Shells	
660 - 1365	Shale with Lime Strgs.	
1365 - 2260	Lime and Shale	Plugged.