


WELL PLUGGING RECORD

Give All Information Completely
Make Required Affidavit
Mail or Deliver Report to:
Conservation Division
State Corporation Commission
800 Bittling Building
Wichita, Kansas

Pawnee County, Sec. 35 Twp. 20S Rge. 16 (E) (W)
Location as "NE/CNW $\frac{1}{4}$ SW $\frac{1}{4}$ " or footage from lines Center of SE $\frac{1}{4}$ of NE $\frac{1}{4}$ of NE $\frac{1}{4}$
Lease Owner Amerada Petroleum Corp.
Lease Name J. L. Franklin Well No. 1
Office Address Box 2040, Tulsa, Okla.
Character of Well (completed as Oil, Gas or Dry Hole) Dry Hole
Date well completed Dec. 20 19 52
Application for plugging filed Dec. 20 19 52
Application for plugging approved Dec. 20 19 52
Plugging commenced Dec. 21 19 52
Plugging completed Dec. 21 19 52
Reason for abandonment of well or producing formation Dry Hole

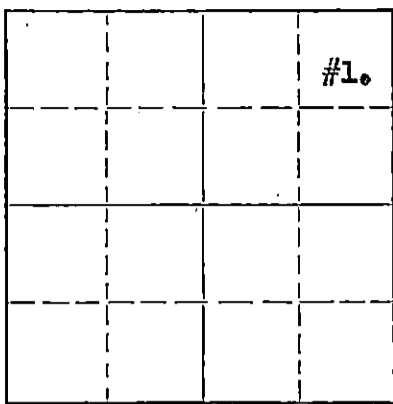

Locate well correctly on above Section Flat

If a producing well is abandoned, date of last production 19
Was permission obtained from the Conservation Division or its agents before plugging was commenced? Yes

Name of Conservation Agent who supervised plugging of this well Mr. C. D. Stough of Great Bend, Kansas.
Producing formation Depth to top Bottom Total Depth of Well 3815' Feet
Show depth and thickness of all water, oil and gas formations.

OIL, GAS OR WATER RECORDS

CASING RECORD

Formation	Content	From	To	Size	Put In	Pulled Out
				8-5/8" OD	1059'	None.

Describe in detail the manner in which the well was plugged, indicating where the mud fluid was placed and the method or methods used in introducing it into the hole. If cement or other plugs were used, state the character of same and depth placed, from feet to feet for each plug set.

Filled hole with heavy mud up to within 270' of top, set bridge plug at 270' from top, mixed & poured in 20 sacks of regular cement through drill pipe on plug. Filled hole with heavy mud up to within 35' of top, set bridge plug at 35' from top, mixed & dumped in 10 sacks of regular cement filling hole to top of 8-5/8" surface casing in bottom of cellar as required by State Pluggers Mr. C. D. Stough of Great Bend, Kansas. Well Plugged & Abandoned 12/21/52.

12-30-52 DEC 30 1952
CONSERVATION DIVISION
Wichita, Kansas

(If additional description is necessary, use BACK of this sheet)
Name of Plugging Contractor Peel Bros. Inc.
Address Hoisington, Kansas.

STATE OF Oklahoma COUNTY OF Tulsa, SS.
C. E. Richardson (employee of owner) or (owner or operator) of the above-described well,
being first duly sworn on oath, says: That I have knowledge of the facts, statements, and matters herein contained and the log of the above-described well as filed and that the same are true and correct. So help me God.

(Signature) C. E. Richardson

SUBSCRIBED AND SWORN TO before me this 29th day of December, 1952

My commission expires January 17, 1955
Notary Public.

PLUGGING
WELL SEC 35 T 20 R 16 S
BOOK PAGE 61 LINE 9

Well No. 1
 Farm Jesse Leigh Franklin
 Elevation 2053' D.F.
 Location Center SE/4 NE/4 NE/4
 990' South of North line
 330' West of East line
 Section 35-20S-16W
 Pawnee County, Kansas
 Company Amerada Petroleum Corporation
 Commenced Drlg. 12-3-52
 Completed Drlg. 12-20-52
 Contractor Peel Brothers, Inc.
 Initial Production Dry Hole

CASING:	SIZE	WEIGHT	FEET	CEMENT	PERFORATIONS
	8-5/8"	24#	1059'	600'	None

FORMATION

Clay	0	60
Sand	60	225
Shale and sand streaks	225	440
Shale and sand	440	510
Sand	510	670
Shale and sand	670	800
Shale	800	1010
Shale and red bed	1010	1048
Anhydrite	1048	1085
shale and anhydrite streaks	1085	1400
Shale	1400	1550
Shale and shells	1550	1700
Sand and shale	1700	1780
Broken lime and shale	1780	1935
Lime	1935	2045
Lime and shale	2045	2935
Lime	2935	2985
Lime and shale	2985	3070
Lime	3070	3720
Lime and conglomerate	3720	3760
Conglomerate	3760	3800
Arbuckle Lime	3800	3815
TOTAL DEPTH		3815'


GEOLOGICAL TOPS:

Heebner	3393'
Toronto	3410'
Douglas	3423'
Brown Lime	3480'
Lansing	3489'
Conglomerate	3757'
Simpson	3775'
Arbuckle	3800'

SCHLUMBERGER TOPS:

Heebner	3094'
Toronto	3412'
Douglas	3424'
Brown Lime	3482'
Lansing	3492'
Conglomerate	3756'
Simpson	3775'
Arbuckle	3805'
Schlumberger T.D.	3811'

Rotary tools used from 0 to 3815'

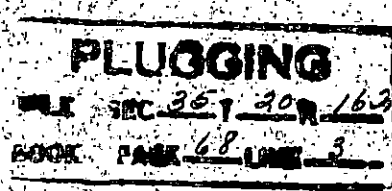

RECEIVED
 THE CORPORATION COMMISSION
 JAN 2 1953
 INSPECTION DIVISION
 Wichita, Kansas