


WELL PLUGGING RECORD

Give All Information Completely
Make Required Affidavit
Mail or Deliver Report to:
Conservation Division
State Corporation Commission
809 Bittig Building
Wichita, Kansas

Pawnee County. Sec. 35 Twp. 20S Rge. — (E) 16 (W)
Location as "NE/CNW&SW¼" or footage from lines SW SW SW
Lease Owner Brunson Prod. & Expl., Inc. & Tomlinson-Kathol, Inc.
Lease Name Brady Well No. 1
Office Address 414 Union Center Bldg. Wichita, Kansas
Character of Well (completed as Oil, Gas or Dry Hole) Dry Hole
Date well completed October 25 19 57
Application for plugging filed October 25 19 57
Application for plugging approved October 25 19 57
Plugging commenced October 25 19 57
Plugging completed October 25 19 57
Reason for abandonment of well or producing formation Dry Hole

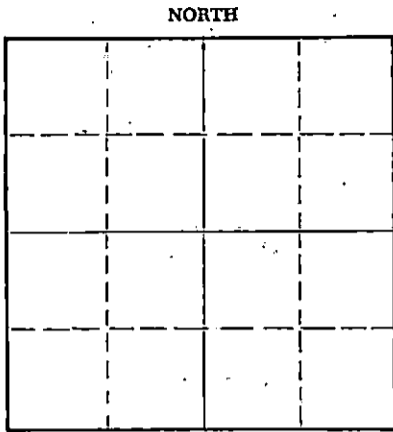

Locate well correctly on above Section Plat

If a producing well is abandoned, date of last production 19
Was permission obtained from the Conservation Division or its agents before plugging was commenced? yes

Name of Conservation Agent who supervised plugging of this well Donald Truan
Producing formation _____ Depth to top _____ Bottom _____ Total Depth of Well 3787 Feet
Show depth and thickness of all water, oil and gas formations.

OIL, GAS OR WATER RECORDS

CASING RECORD

FORMATION	CONTENT	FROM	TO	SIZE	PUT IN	PULLED OUT
				8-5/8"	1018	None

Describe in detail the manner in which the well was plugged, indicating where the mud fluid was placed and the method or methods used in introducing it into the hole. If cement or other plugs were used, state the character of same and depth placed, from _____ feet to _____ feet for each plug set.

Plug at 550' 20 sacks cement through pipe Mud to 250'
Plug at 250' 20 sacks cement through pipe Mud to 40'
Plug with 1/3 sack hulls cement with 10 sacks cement to surface.

RECEIVED
STATE CORPORATION COMMISSION
OCT 31 1957
CONSERVATION DIVISION
Wichita, Kansas

10-31-57

(If additional description is necessary, use BACK of this sheet)
Name of Plugging Contractor Tomlinson-Kathol, Inc.
Address 414 Union Center Building - Wichita, Kansas

STATE OF Kansas, COUNTY OF Sedgwick, ss.
Warren E. Tomlinson (employee of owner) or (owner or operator) of the above-described well, being first duly sworn on oath, says: That I have knowledge of the facts, statements, and matters herein contained and the log of the above-described well as filed and that the same are true and correct. So help me God.
(Signature) Warren E. Tomlinson
414 Union Center Bldg, Wichita, Kansas
(Address)

SUBSCRIBED AND SWORN TO before me this 28th day of October, 19 57

My commission expires Jan. 19, 1961

Esther Lamore
Notary Public.

PLUGGING
FILE SEC. 35 T. 20 R. 16
BOOK PAGE 57 LINE 38

DRILLERS LOG
1 BRADY
SW SW SW, SEC. 35-20S-16W
PAWNEE COUNTY, KANSAS

Operator - Brunson Production & Exploration, Inc.
and Tomlinson-Kathol, Inc.

Commenced - 10/14/57
Completed - 10/25/57
Elevation - 1997 KB

Contractor - Tomlinson-Kathol, Inc.

<u>From</u>	<u>To</u>	<u>Description</u>	<u>Remarks</u>
0	280	Sand and clay	
280	435	Shale	
435	540	Sand	
540	940	Shale and streaks of sand	
940	1000	Sand and shale	
1000	1018	Anhydrite	8-5/8" Casing set @ 1018' with 425 sacks cement, 10 sacks Calcium chloride. Cement circulated.
1018	1040	Anhydrite	
1040	1880	Shale	
1880	1925	Shale and lime	
1925	2320	Lime	
2320	2765	Lime and shale	
2765	2860	Shale with lime streaks	
2860	3190	Shale and lime	
3190	3251	Lime	
3251	3317	Lime with shale streaks	
3317	3418	Lime and shale	
3418	3446	Shale and lime	
3446	3747	Lime and shale	
3747	3787	Dolomite	
3787		Total Depth of Hole	Schlumberger
		Dry and Abandoned	

RECEIVED
STATE CORPORATION COMMISSION
OCT 31 1957
DIVISION
KANSAS

I certify that to the best of my knowledge and belief, the above represents a true and accurate Driller's Log record of the captioned well.

PLUGGING
FILE SEC 35 T 20 R 16W
BOOK PAGE 57 LINE 38

Warren E. Tomlinson
Warren E. Tomlinson

State of Kansas
County of Sedgwick

Subscribed and sworn to before me this 28th day of October, 1957.



Esther Lamore
Notary Public

My Commission expires Jan. 19, 1961.