

STATE OF KANSAS
STATE CORPORATION COMMISSION

Form CP-4

Give All Information Completely
Make Required Affidavit
Mail or Deliver Report to:
Conservation Division
State Corporation Commission
212 No. Market
Wichita, Kansas 67202

WELL PLUGGING RECORD

Pawnee County. Sec. 35 Twp. 20S Rge. 16 NE W (W)

Location as "NE/CNW/SW" or footage from lines SW SW SE

Lease Owner Tenneco Oil Company

Lease Name Glennis Carr Well No. 1-35

Office Address 2000 Classen Center, Oklahoma City, Oklahoma

Character of Well (completed as Oil, Gas or Dry Hole) Dry Hole

Date well completed April 19 19 71

Application for plugging filed April 19 19 71

Application for plugging approved April 19 19 71


Plugging commenced April 19 19 71

Plugging completed April 19 19 71

Reason for abandonment of well or producing formation No Productible Zone.

If a producing well is abandoned, date of last production 19

Was permission obtained from the Conservation Division or its agents before plugging was commenced? Yes

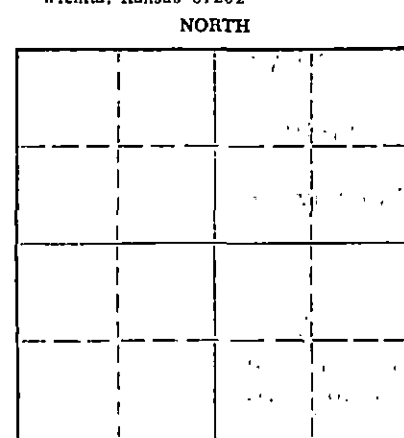

Locate well correctly on above Section Plat

Name of Conservation Agent who supervised plugging of this well Leo F. Massey

Producing formation _____ Depth to top _____ Bottom _____ Total Depth of Well 3860 Feet

Show depth and thickness of all water, oil and gas formations.

OIL, GAS OR WATER RECORDS

CASING RECORD

| FORMATION | CONTENT | FROM | TO | SIZE | PUT IN | PULLED OUT |
|-----------|---------|------|----|-------|--------|------------|
| | | | | 8 5/8 | 1035 | 0 |
| | | | | | | |
| | | | | | | |
| | | | | | | |
| | | | | | | |
| | | | | | | |
| | | | | | | |
| | | | | | | |
| | | | | | | |

Describe in detail the manner in which the well was plugged, indicating where the mud fluid was placed and the method or methods used in introducing it into the hole. If cement or other plugs were used, state the character of same and depth placed, from _____ feet to _____ feet for each plug set.

Gunned up pits forming heavy mud. Filled hole with heavy mud and spotted 25 sacks cement at 300 feet. Filled hole with heavy mud, pushed plug and 1/2 sack hulls to 40 feet, capped with 10 sacks cement to base of well cellar. Job complete at 9:00 AM, April 19, 1971.

RECEIVED
STATE CORPORATION COMMISSION

SEP 8 1972

CONSERVATION DIVISION
Wichita, Kansas

(If additional description is necessary, use BACK of this sheet)

Name of Plugging Contractor GARVEY DRILLING COMPANY

Address Box 1164, Great Bend, Kansas 67530

STATE OF Kansas, COUNTY OF Barton, ss.

Ben E. Inruh (employee of owner) of the above-described well, being first duly sworn on oath, says: That I have knowledge of the facts, statements, and matters herein contained and the log of the above-described well as filed and that the same are true and correct. So help me God.

(Signature) Ben E. Inruh

Box 1164, Great Bend, Kansas 67530
(Address)

SUBSCRIBED AND SWORN TO before me this 20th day of April, 1971


My commission expires July 8, 1974

James C. Thomas
Notary Public.

WELL LOG

COMPANY Tenneco Oil Company
 FARM Glennis Carr NO. 1-35
 TOTAL DEPTH 3860'
 COMM. 4-12-71 COMP. 4-19-71
 CONTRACTOR Garvey Drilling Company

SEC. 35 T. 20S R. 16W
 LOC. SW SW SE
 COUNTY Pawnee, Kansas

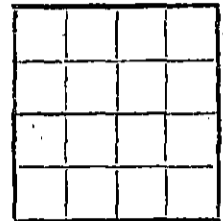

CASING
8 5/8" @ 1035' w/450sx

ELEVATION

PRODUCTION D & A

FIGURES INDICATE BOTTOM OF FORMATIONS

- 40' Clay
- 420' Shale
- 576' D-Sand
- 1030' Shells & Shale
- 1035' Anhydrite
- 1580' Shale
- 1930' Shale & Lime
- 2170' Lime & Shale
- 2600' Shale & Lime
- 3075' Lime & Shale
- 3580' Lime
- 3801' Lime & Sand
- 3810' Arbuckle
- 3860' Arbuckle
- 3860' RTD

RECEIVED
 STATE CORPORATION COMMISSION
 SEP 8 1972
 CONSERVATION DIVISION
 Wichita, Kansas

State of Kansas
 County of Barton } ss

I, Charlene Marker of Garvey Drilling Company

upon oath state the above and foregoing is a true and correct copy of the log of the Glennis Carr No. 1-35 well.

Charlene Marker

Subscribed and sworn to before me this 19th day of April 19 71

My Commission Expires: July 8, 1974

James A. Morris
 NOTARY PUBLIC