

STATE OF KANSAS
STATE CORPORATION COMMISSION
CONSERVATION DIVISION
P. O. BOX 17027
WICHITA, KANSAS 67217

FORM CP-4

WELL PLUGGING RECORD

Rice County, Sec. 14 Twp. 20 Rge. (E) 8 (W)

Location as "NE/CNW/SE/SW" or footage from lines 2415' FEL 1399' FSL

Lease Owner Northern Natural Gas Company

Lease Name Hollinger OB14-01 Well No. OB14-01

Office Address P. O. Box 88, Lyons, Kansas 67554

Character of Well (completed as Oil, Gas or Dry Hole)

Date well completed 5-21 1975

Application for plugging filed 5-20 1975

Application for plugging approved 5-20 1975


Plugging commenced 10:30 PM 5-20 1975

Plugging completed 4:45 AM 5-21 1975

Reason for abandonment of well or producing formation

If a producing well is abandoned, date of last production 19

Was permission obtained from the Conservation Division or its agents before plugging was commenced? yes

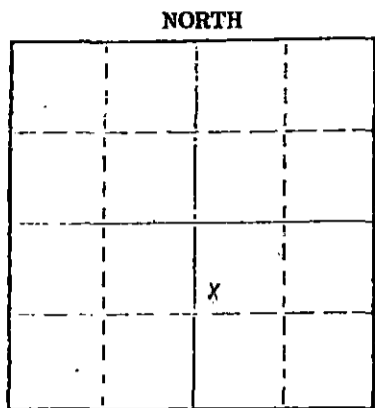

Locate well correctly on above Section Plat

Name of Conservation Agent who supervised plugging of this well

Producing formation none Depth to top Bottom Total Depth of Well 4200

Show depth and thickness of all water, oil and gas formations.

OIL, GAS OR WATER RECORDS

CASING RECORD

FORMATION	CONTENT	FROM	TO	SIZE	PUT IN	PULLED OUT
		0	42	13-3/8"		none
		0	1053	8-5/8"		None

Describe in detail the manner in which the well was plugged, indicating where the mud fluid was placed and the method or methods used in introducing it into the hole. If cement or other plugs were used, state the character of same and depth placed, from feet to feet for each plug set.

Hole full of drilling mud. Halliburton mixed and spotted 50 sacks 50-50 Poz-mix cement from 3940 to 3740 through drill pipe. Set 8-5/8 Baker cast iron on electric line @ 1000 feet. Pushed 8-5/8 Halliburton wooden plug to 90 feet and Halliburton mixed 30 sacks of cement and spotted from 90 to surface.

(TEMPORARY ABANDON)

RECEIVED
STATE CORPORATION COMMISSION
MAY 27 1975

Name of Plugging Contractor (If additional description is necessary, use BACK of this sheet)
Address CONSERVATION DIVISION
Wichita, Kansas

STATE OF KANSAS COUNTY OF RICE ss. 5-27-75

(employee of owner) or (owner or operator) of the above-described well, being first duly sworn on oath, says: That I have knowledge of the facts, statements, and matters herein contained and the log of the above-described well as filed and that the same are true and correct. So help me God.

(Signature) O J Buck

SUBSCRIBED AND SWORN TO before me this 22nd day of MAY 19 75

(Address) Mary E. Kennedy
Notary Public.

My commission expires
NOTARY PUBLIC
MARY E. KENNEDY
Rice Co., Kans.
My Comm. Exp. May 8, 1978
KANSAS